

JAN 24 1996

ROSCOMMON COUNTY
PEER GROUP APPROVAL

ROSCOMMON COUNTY REMONUMENTATION
LAND CORNER RECORDATION CERTIFICATE

COMMISSION

DATE 12-28-94

Filing Requirement of Act 74, Mich. P.A. 1970

For corners in
ROSCOMMON

(County)

Located In:

Corner Code #

TO BE FILED IN LIBER 3 OF LAND CORNER

- 1. Public Land Survey T 23N R 4W L-3
- T _____ R _____
- T _____ R _____
- T _____ R _____
- 2. Property Controlling S _____ T _____ R _____
- in Section S _____ T _____ R _____
- 3. Miscellaneous S _____ T _____ R _____
- Property in Sec. S _____ T _____ R _____

**SURVEY &
REMONUMENTATION**

APR 05 1996

STATE OF MICHIGAN
ROSCOMMON COUNTY
RECORDED

28 DEC 94 1:05 P.M.

ROBERT W. SMITH
REGISTER OF DEEDS

COMMISSION

- 4. Lot No. _____, Recorded Plat _____
- 5. Private Claims _____

	A	B	C	D	E	F	G	H	I	J	K	L	M
2	6	5	4	3	2	1							
3													
4	7	8	9	10	11	12							
5													
6	18	17	16	15	14	13							
7													
8	19	20	21	22	23	24							
9													
10	30	29	28	27	26	25							
11													
12	31	32	33	34	35	36							
13													


Timothy L. Lapham ; in a field survey on December, 19 94, do hereby certify that under requirements of P.A. 74, Michigan P.A. of 1970, the corner points mentioned in lines 1 and 2 above were in conformance with regulations and rules therefore as required in the current manual of survey instructions of the United States Department of the Interior, Bureau of Land Management or by a decree of a Court of Law and/or that the corner points mentioned in lines 3, 4 and 5 above were in conformance with the rules of the Michigan Board of Land Surveyors or by a Decree of a Court of Law; established, re-established, monumented, re-monumented, recovered, found as expressed below:

NOTE: Not more than 4 corners, all in the same town and range, may be recorded on this certificate.

A. Description of original monument and accessories and/or subsequent restoration:
L-3: 1852 CURTIS, SET POST, CEDAR 10" N35E 30LK., CEDAR 10" S50W 18 LK., NO SURVEYS OR LCRCs OF RECORD

B. Description of corner evidence found and/or method applied in restoring or reestablishing corner:
L-3: NO EVIDENCE OF CORNER POSITION FOUND, SET CORNER BY SINGLE PROPORTIONATE MEASURE BETWEEN K-3 AND M-3, ACCEPTED ESTABLISHED POSITION AS BEST EVIDENCE OF ORIGINAL CORNER POSITION. CORNER APPROVED AT PEER REVIEW MEETING 12-28, 1994. SEE DOSSIER FOR ADDITIONAL INFORMATION.

C. Description of monument for corner and accessories established to perpetuate locating the position of the corner:
L-3: SET 3/4"x60" BLACK PIPE 54" INTO GROUND WITH PLASTIC PS CAP #27595
SOUTH 46.92 FACE OF CARSONITE POST
S11E 23.58 SET NAIL AND TAG IN 8" CEDAR
N40W 9.09 SET NAIL AND TAG IN 6" CEDAR
N52E 20.97 SET NAIL AND TAG IN 8" CEDAR
N78E 10.71 SET NAIL AND TAG IN 4" SPRUCE
MONUMENT LOCATED IN CEDAR AND SPRUCE SWAMP 90'+/- NORTH OF SW-NE POWER LINE

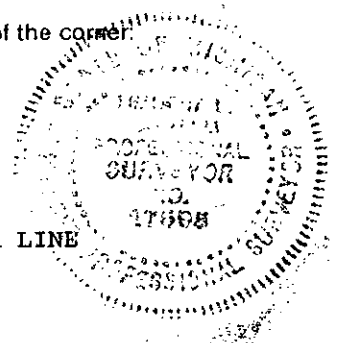

Signed by [Signature]
Surveyor's Michigan License No. 27595

Date 12/27/94

Line 0 Page 710