

JAN 24 1995

ROSCOMMON COUNTY  
PEER GROUP APPROVAL

DATE 12-28-94  
*MEM*

ROSCOMMON COUNTY REMONUMENTATION  
LAND CORNER RECORDATION CERTIFICATE  
Filing Requirement of Act 74, Mich. P.A. 1970

COMMISSION

STATE OF MICHIGAN  
ROSCOMMON COUNTY  
RECORDED

28 DEC 94 1:05 P.M.

ROBERT W. SMITH  
REGISTER OF DEEDS

For corners in  
ROSCOMMON  
(County)

Located In: Corner Code #

- 1. Public Land Survey T 23N R 4W M-3  
T \_\_\_\_\_ R \_\_\_\_\_  
T \_\_\_\_\_ R \_\_\_\_\_ SURVEY &  
T \_\_\_\_\_ R \_\_\_\_\_ REMONUMENTATION
- 2. Property Controlling S \_\_\_\_\_ T \_\_\_\_\_ R \_\_\_\_\_  
in Section S \_\_\_\_\_ T \_\_\_\_\_ R \_\_\_\_\_
- 3. Miscellaneous S \_\_\_\_\_ T \_\_\_\_\_ R \_\_\_\_\_ APR 05 1996  
Property in Sec. S \_\_\_\_\_ T \_\_\_\_\_ R \_\_\_\_\_

TO BE FILED IN LIBER 3 LAND CORNERS  
Register of Deeds Stamp & File Number

COMMISSION

- 4. Lot No. \_\_\_\_\_, Recorded Plat \_\_\_\_\_
- 5. Private Claims \_\_\_\_\_

	A	B	C	D	E	F	G	H	I	J	K	L	M
2	6	5	4	3	2								
3													
4	7	8	9	10	11	12							
5													
6	18	17	16	15	14	13							
7													
8	19	20	21	22	23	24							
9													
10	30	29	28	27	26	25							
11													
12	31	32	33	34	35	36							
13													


I, Timothy L. Lapham, in a field survey on December, 19 94, do hereby certify that under requirements of P.A. 74, Michigan P.A. of 1970, the corner points mentioned in lines 1 and 2 above were in conformance with regulations and rules therefore as required in the current manual of survey instructions of the United States Department of the Interior, Bureau of Land Management or by a decree of a Court of Law and/or that the corner points mentioned in lines 3, 4 and 5 above were in conformance with the rules of the Michigan Board of Land Surveyors or by a Decree of a Court of Law; established, re-established, monumented, re-monumented, recovered, found as expressed below:

NOTE: Not more than 4 corners, all in the same town and range, may be recorded on this certificate.

A. Description of original monument and accessories and/or subsequent restoration:  
M-3: 1838 BRINK, SET POST, YELLOW PINE 12" N39W 50LK., YELLOW PINE 13" S31W 30LK.  
NO SURVEYS OR LCRCs OF RECORD

B. Description of corner evidence found and/or method applied in restoring or reestablishing corner:  
M-3: FOUND 1/2"x36" IRON BAR, EXCAVATED TO 3' AND FOUND NO FURTHER EVIDENCE, IRON FALLS IN THE CENTERLINE OF N-S ROAD 7'+/- SOUTH OF ROAD EAST, NO OTHER EVIDENCE OR CORNER POSITION, DISTANCE SOUTH REASONABLY CLOSE TO GLO, ACCEPTED FOUND IRON AS BEST EVIDENCE OF ORIGINAL CORNER POSITION.  
CORNER APPROVED AT PEER REVIEW MEETING 12-28, 1994. SEE DOSSIER FOR ADDITIONAL INFORMATION.

C. Description of monument for corner and accessories established to perpetuate locating the position of the corner:  
M-3: SET 2-1/2"x24" CAST IRON MONUMENT WITH BRASS DISC MARKED 1994-27595  
N48E 78.12 SET NAIL AND TAG IN NW FACE 5" OAK  
S45E 40.00 FACE OF CARSONITE POST  
S32W 48.80 SET NAIL AND TAG IN SE FACE 6" POPLAR  
N44W 78.75 SET NAIL AND TAG IN SW FACE 8" POPLAR  
MONUMENT 7'+/- SOUTH OF INTERSECTION ROADS N-S-E

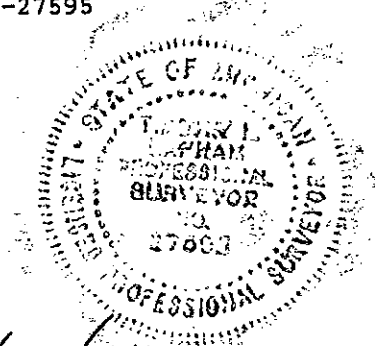

Signed by [Signature] Date 12/27/94  
Surveyor's Michigan License No. 27595