

ROSCOMMON COUNTY
PEER GROUP APPROVAL
DATE 12-28-94
MJM

ROSCOMMON COUNTY REMONUMENTATION
LAND CORNER RECORDATION CERTIFICATE
Filing Requirement of Act 74, Mich. P.A. 1970

JAN 24 1995
COMMISSION
STATE OF MICHIGAN
ROSCOMMON COUNTY
RECORDED

28 DEC 94 1:07 P.M.
ROBERT W. SMITH
REGISTER OF DEEDS

For corners in
ROSCOMMON
(County)

Located In: Corner Code #

- 1. Public Land Survey T 23N R 4W M-4
- T _____ R _____
- T _____ R _____
- T _____ R _____
- 2. Property Controlling S _____ T _____ R _____
- in Section S _____ T _____ R _____
- 3. Miscellaneous S _____ T _____ R _____
- Property in Sec. S _____ T _____ R _____

**SURVEY &
REMONUMENTATION**
APR 05 1996

TO BE FILED IN LIBER 3 OF LAND CORNER
Register of Deeds Stamp & File Number

- 4. Lot No. _____, Recorded Plat **COMMISSION**
- 5. Private Claims _____

	A	B	C	D	E	F	G	H	I	J	K	L	M
2	6	5	4	3	2	1							
3													
4	7	8	9	10	11	12							
5													
6	18	17	16	15	14	13							
7													
8	19	20	21	22	23	24							
9													
10	30	29	28	27	26	25							
11													
12	31	32	33	34	35	36							
13													


Timothy L. Lapham, in a field survey on December, 1994, do hereby certify that under requirements of P.A. 74, Michigan P.A. of 1970, the corner points mentioned in lines 1 and 2 above were in conformance with regulations and rules therefore as required in the current manual of survey instructions of the United States Department of the Interior, Bureau of Land Management or by a decree of a Court of Law and/or that the corner points mentioned in lines 3, 4 and 5 above were in conformance with the rules of the Michigan Board of Land Surveyors or by a Decree of a Court of Law; established, re-established, monumented, re-monumented, recovered, found as expressed below:

NOTE: Not more than 4 corners, all in the same town and range, may be recorded on this certificate.

A. Description of original monument and accessories and/or subsequent restoration:
M-4: 1838 BRINK, SET POST, BIRCH 10" N13W 24LK., TAMARACK 10" S59W 18LK.
NO SURVEYS OR LCRCs OF RECORD

B. Description of corner evidence found and/or method applied in restoring or reestablishing corner:
M-4: FOUND 1/2"x30" IRON BAR EXCAVATED TO 3' AND FOUND NO FURTHER EVIDENCE, FOUND CORNER 10'+/- EAST OF CENTERLINE ROAD N-S, CORNER MATERIAL SIMILAR TO OTHER CORNERS IN AREA AND NEAR MIDPOINT BETWEEN M-3 AND M-5, ACCEPTED FOUND IRON AS BEST EVIDENCE OF ORIGINAL CORNER POSITION. CORNER APPROVED AT PEER REVIEW MEETING 12-28, 1994. SEE DOSSIER FOR ADDITIONAL INFORMATION.

C. Description of monument for corner and accessories established to perpetuate locating the position of the corner:
M-4: SET 2-1/2"x24" CAST IRON MONUMENT WITH BRASS DISK MARKED 1994-27595
N32E 22.38 SET NAIL AND TAG IN NW FACE OF 8" JACK PINE
S22E 5.96 SET NAIL AND TAG IN NE FACE OF 5" MAPLE
WEST 19.45 FACE OF CARSONITE POST
N34W 49.51 SET NAIL AND TAG IN SE FACE OF 10" JACK PINE
MONUMENT 10'+/- EAST OF CENTERLINE OF N-S GRAVEL ROAD

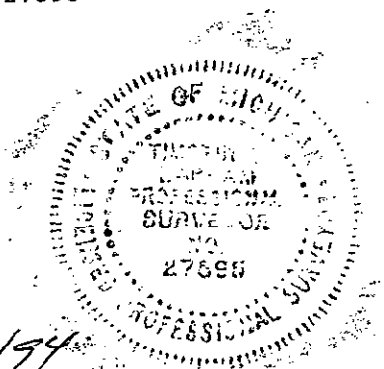

Signed by [Signature]
Surveyor's Michigan License No. 27595

Date 12/27/94