

JAN 24 1996

COMMISSION

ROSCOMMON COUNTY
PEER GROUP APPROVAL
DATE 12-28-94

ROSCOMMON COUNTY REMONUMENTATION
LAND CORNER RECORDATION CERTIFICATE
Filing Requirement of Act 74, Mich. P.A. 1970

For corners in
ROSCOMMON
(County)

Located In: Corner Code #

TO BE FILED IN LIBER 3 OF LAND CORNERS

STATE OF MICHIGAN
ROSCOMMON COUNTY
RECORDED

28 DEC 94 1:06 P.M.

ROBERT W. SMITH
REGISTER OF DEEDS

Register of Deeds Stamp & File Number

- 1. Public Land Survey T 23N R 4W M-6
T ___ R ___
T ___ R ___ SURVEY &
T ___ R ___ MONUMENTATION
- 2. Property Controlling S ___ T ___ R ___
in Section S ___ T ___ R ___
3. Miscellaneous S ___ T ___ R ___
Property in Sec. S ___ T ___ R ___ APR 05 1996
- 4. Lot No. _____, Recorded Plat _____
- 5. Private Claims _____

COMMISSION

	A	B	C	D	E	F	G	H	I	J	K	L	M
2	6	5	4	3	2								
3													
4	7	8	9	10	11	12							
5													
6	18	17	16	15	14	13							
7													
8	19	20	21	22	23	24							
9													
10	30	29	28	27	26	25							
11													
12	31	32	33	34	35	36							
13													


Timothy L. Lapham in a field survey on December 19 94 do hereby certify that under requirements of P.A. 74, Michigan P.A. of 1970, the corner points mentioned in lines 1 and 2 above were in conformance with regulations and rules therefore as required in the current manual of survey instructions of the United States Department of the Interior, Bureau of Land Management or by a decree of a Court of Law and/or that the corner points mentioned in lines 3, 4 and 5 above were in conformance with the rules of the Michigan Board of Land Surveyors or by a Decree of a Court of Law; established, re-established, monumented, re-monumented, recovered, found as expressed below:

NOTE: Not more than 4 corners, all in the same town and range, may be recorded on this certificate.

A. Description of original monument and accessories and/or subsequent restoration:
M-6: 1838 BRINK, SET POST, CEDAR 7" N3W 18LK., ASPEN 8" S49W 18 LK.
DATE/SURVEYOR UNKNOWN, LCRC 2-377, 1/2" IRON ROD, 3 WITNESSES
9/1943 HENNING, UNRECORDED, NO MATERIAL OR WITNESSES

B. Description of corner evidence found and/or method applied in restoring or reestablishing corner:
M-6: FOUND 1/2"x18" IRON BAR EXCAVATED TO 3' AND NO FURTHER EVIDENCE FOUND, FOUND 3 WITNESSES OF RECORD, DISTANCE NORTH AND SOUTH CLOSELY MATCH HENNING SURVEY. ACCEPTED FOUND IRON AS BEST EVIDENCE OF ORIGINAL CORNER POSITION.
CORNER APPROVED AT PEER REVIEW MEETING 12-28, 1994. SEE DOSSIER FOR ADDITIONAL INFORMATION.

C. Description of monument for corner and accessories established to perpetuate locating the position of the corner:
M-6: SET STANDARD 2-1/2"x24" CAST IRON MONUMENT WITH BRASS DISK MARKED 1994 - 27595
S45W 53.67 SET NAIL AND TAG SE FACE 16" MAPLE
N45E 70.96 SET NAIL AND TAG SE FACE 18" MAPLE
S80E 48.72 SET NAIL AND TAG NE FACE 14" BIRCH
WEST 33.00 FACE OF CARSONITE POST
N48W 40.89 SET NAIL AND TAG SW FACE 8" SPRUCE

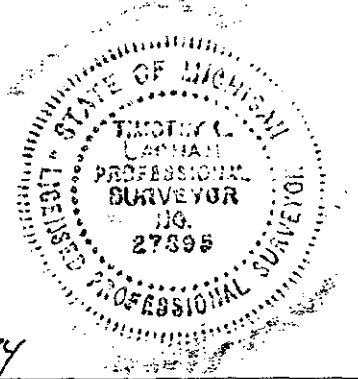

Signed by [Signature]
Surveyor's Michigan License No. 27595

Date 12/27/94

1 1250 2 PAGE 201