

**SURVEY &
REMONUMENTATION**

4023

MAY 28 1997

**LAND CORNER RECORDATION CERTIFICATE
COMMISSION**

Filing Requirement of Act 74, Mich. P.A. 1970

For corners in

<u>Roscommon</u> <small>(County)</small>	Located In:	Corner Code #	
1. Public Land Survey	T <u>23N</u> R <u>1W</u>	<u>A - 9</u>	
	T _____ R _____	_____	
	T _____ R _____	_____	
	T _____ R _____	_____	
2. Property Controlling in Section	S _____ T _____ R _____	_____	
	S _____ T _____ R _____	_____	
3. Miscellaneous Property in Sec.	S _____ T _____ R _____	_____	
	S _____ T _____ R _____	_____	
4. Lot No. _____, Recorded Plat _____			
5. Private Claims _____			

STATE OF MICHIGAN
ROSCOMMON COUNTY
RECORDED

17 JUN 96 3:38 P.M.

ROBERT W. SMITH
REGISTER OF DEEDS

TO BE FILED IN LIBER 3 OF LAND CORNERS
Register of Deeds Stamp & File Number

I, Marvin E. Myers, in a field survey on March, 1996,

do hereby certify that under requirements of P.A. 74, Michigan P.A. of 1970, the corner points mentioned in lines 1 and 2 above were in conformance with regulations and rules therefore as required in the current manual of survey instructions of the United States Department of the Interior, Bureau of Land Management or by a decree of a Court of Law and/or that the corner points mentioned in lines 3, 4 and 5 above were in conformance with the rules of the Michigan Board of Land Surveyors or by a Decree of a Court of Law; established, re-established, monumented, re-monumented, recovered, found as expressed below:

NOTE: Not more than 4 corners, all in the same town and range, may be recorded on this certificate.

A	B	C	D	E	F	G	H	I	J	K	L	M
2	6	5	4	3	2	1						
3												
4	7	8	9	10	11	12						
5												
6	18	17	16	15	14	13						
7												
8	19	20	21	22	23	24						
9												
10	30	29	28	27	26	25						
11												
12	31	32	33	34	35	36						
13												

A. Description of original monument and accessories and/or subsequent restoration:

GLO-William Burt 1852 Mon-Set Post WIT: 5" Tamarack S04°W 4.55 lks. 4" Tamarack S04°E 5.58 lks.	M. Schaaf Mon-Fd. cor reestablished and replaced	G.D. Henning Feb. 9, 1946 Mon-Fd. squared cedar post with old line West - corner accepted Set new cedar post 4" squared
--	--	--

B. Description of corner evidence found and/or method applied in restoring or reestablishing corner:


Henning survey 1946 no evidence of cedar post found. Reestablished position from ties to corners North and West as shown in Henning survey.
A-9 to A-7 5763.69'

**ROSCOMMON COUNTY
PEER GROUP APPROVAL
DATE May 18, 1996**

Marvin E. Myers
**Marvin E. Myers, P.S.
County Surveyor**

C. Description of monument for corner and accessories established to perpetuate locating the position of the corner:

Monument - Set 3/4" ID X 54" pipe & cap "MEM 31600"
WIT: Set 4' wood stake 3' into ground East 10.00'
Set 4' wood stake 3' into ground North 10.00'
Set 4' wood stake 3' into ground West 10.00'
Set 4' wood stake 3' into ground South 10.00'
Set carsonite post South 0.35'

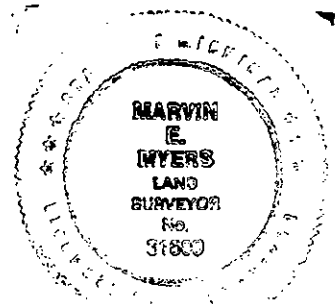

Signed by *Marvin E. Myers*
Surveyor's Michigan License No. 31600

Date May 17, 1996