

8379

# SURVEY & REMONUMENTATION

ROSCOMMON COUNTY REMONUMENTATION  
APR 24 1995 LAND CORNER RECORDATION CERTIFICATE  
COMMISSION Filing Requirement of Act 74, Mich. P.A. 1970

STATE OF MICHIGAN  
ROSCOMMON COUNTY  
REGISTER

15 NOV 94 9:14 A.M.

For corners in  
Roscommon  
(County)

Located In: Corner Code #

- 1. Public Land Survey T 23 R 1 W G - 9  
T \_\_\_\_\_ R \_\_\_\_\_  
T \_\_\_\_\_ R \_\_\_\_\_  
T \_\_\_\_\_ R \_\_\_\_\_
- 2. Property Controlling S \_\_\_\_\_ T \_\_\_\_\_ R \_\_\_\_\_  
in Section S \_\_\_\_\_ T \_\_\_\_\_ R \_\_\_\_\_
- 3. Miscellaneous S \_\_\_\_\_ T \_\_\_\_\_ R \_\_\_\_\_  
Property in Sec. S \_\_\_\_\_ T \_\_\_\_\_ R \_\_\_\_\_
- 4. Lot No. \_\_\_\_\_, Recorded Plat \_\_\_\_\_
- 5. Private Claims \_\_\_\_\_

TO BE FILED IN LIBER 3 OF LAND CORNERS

Register of Deeds Stamp & File Number

I, Frank J. Arleth, in a field survey on November, 19 94, do hereby certify that under requirements of P.A. 74, Michigan P.A. of 1970, the corner points mentioned in lines 1 and 2 above were in conformance with regulations and rules therefore as required in the current manual of survey instructions of the United States Department of the Interior, Bureau of Land Management or by a decree of a Court of Law and/or that the corner points mentioned in lines 3, 4 and 5 above were in conformance with the rules of the Michigan Board of Land Surveyors or by a Decree of a Court of Law; established, re-established, monumented, re-monumented, recovered, found as expressed below:

**NOTE: Not more than 4 corners, all in the same town and range, may be recorded on this certificate.**


- A. Description of original monument and accessories and/or subsequent restoration:  
William Burt set post 1852 1949 Henning set 4"x48" concrete monument used same wit: as before  
Maple 8" S43°W 23 Lks  
Maple 5" N75°E 21 Lks  
Ostling & Henning 1944  
Set 4" squared cedar post  
BT 12" Hemlock N47°E 22.7'  
BT 5" Aspen N35°W 19.4'  
Corner is recorded as P. O. B. for Plat of Carter Woods as recorded by Ostling April 1963 L.5 P. 7.

Also recorded in Plat of Land O'Lake 5th addition by Ostling Oct. 1960 L. 4, P. 44.

- B. Description of corner evidence found and/or method applied in restoring or reestablishing corner:  
October 1994 Arleth Found Concrete monument 30" below surface. Found concrete monument S89°35'W 33.0', also found concrete monument ( LOL #5) S0°07'E 33.0'. Corner is 14' West of centerline of Lakewoods Beach Road on North side of driveway.  
No Old witness found.

- C. Description of monument for corner and accessories established to perpetuate locating the position of the corner.  
Set Roscommon County Standard monument over concrete monument . G-9  
N & T Power pole S61°30'E 113.20  
N & T Group of maples S15°E 97.55  
N & T Power pole S37°W 39.48  
N & T 12" Maple N58°30'W 37.76  
N & T N. pine N7 W 71°42  
N & T Power pole N46°E 98.70  
Set carsonite post West 32.0'.

	A	B	C	D	E	F	G	H	I	J	K	L	M
2	6	5	4	3	2	1							
3													
4	7	8	9	10	11	12							
5													
6	18	17	16	15	14	13							
7													
8	19	20	21	22	23	24							
9													
10	30	29	28	27	26	25							
11													
12	31	32	33	34	35	36							
13													

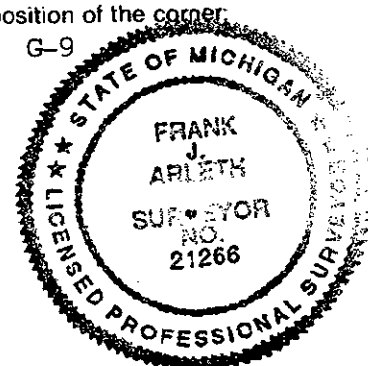

Signed by Frank J. Arleth  
Surveyor's Michigan License No. 21266 P.S.

Date 11/11/94

DATE 11/10/94 Peer Group Approved

FORM APPROVED BY MICHIGAN STATE BOARD OF LAND SURVEYORS, JAN. 28, 1971  
REVISED MAY 14, 1975  
REVISED JAN., 1983

**LIBER 3 PAGE 159**