

**SURVEY &  
8380 REMONUMENTATION**

ROSCOMMON COUNTY REMONUMENTATION

APR 24 1995 LAND CORNER RECORDATION CERTIFICATE

COMMISSION Filing Requirement of Act 74, Mich. P.A. 1970

STATE OF MICHIGAN  
LAND SURVEYORS BOARD  
RECEIVED

15 NOV 7 9:14 A.M.

For corners in

Roscommon  
(County)

Located In:

Corner Code #

- |                                       |   |    |   |   |   |        |
|---------------------------------------|---|----|---|---|---|--------|
| 1. Public Land Survey                 | T | 23 | R | 1 | W | G - 10 |
|                                       | T |    | R |   |   |        |
|                                       | T |    | R |   |   |        |
|                                       | T |    | R |   |   |        |
| 2. Property Controlling<br>in Section | S |    | T |   | R |        |
|                                       | S |    | T |   | R |        |
| 3. Miscellaneous<br>Property in Sec.  | S |    | T |   | R |        |
|                                       | S |    | T |   | R |        |

TO BE FILED IN LIBER 3 OF LAND CORNERS

Register of Deeds Stamp & File Number

4. Lot No. \_\_\_\_\_, Recorded Plat \_\_\_\_\_
5. Private Claims \_\_\_\_\_

	A	B	C	D	E	F	G	H	I	J	K	L	M
2	6	5	4	3	2	1							
3													
4	7	8	9	10	11	12							
5													
6	18	17	16	15	14	13							
7													
8	19	20	21	22	23	24							
9													
10	30	29	28	27	26	25							
11													
12	31	32	33	34	35	36							
13													

I, Frank J. Arleth, in a field survey on November, 1994, do hereby certify that under requirements of P.A. 74, Michigan P.A. of 1970, the corner points mentioned in lines 1 and 2 above were in conformance with regulations and rules therefore as required in the current manual of survey instructions of the United States Department of the Interior, Bureau of Land Management or by a decree of a Court of Law and/or that the corner points mentioned in lines 3, 4 and 5 above were in conformance with the rules of the Michigan Board of Land Surveyors or by a Decree of a Court of Law; established, re-established, monumented, re-monumented, recovered, found as expressed below:

**NOTE: Not more than 4 corners, all in the same town and range, may be recorded on this certificate.**

A. Description of original monument and accessories and/or subsequent restoration:

William Burt set post 1852  
Aspen 12" N76°W 20 Lks  
Aspen 14" S62°E 9 Lks

1944 Henning & Ostling set 1 1/4" x 5' Pipe in corner.  
NBD 5" Cedar S55°W 29.0  
NBT 6" Aspen S55°E 32.9

Recorded Land O'Lakes Subdivision 3rd addition  
L. 4 P. 28 Ostling 1959, recorded Land O'Lakes  
Subdivision No. 11, Jand 1971.  
Cavanagh 1993 found concrete monument at corner  
Wit: 9" Balsam N14°E 22.65  
5" Maple S13°E 10.10  
5" Maple S67°E 13.05  
4" Maple N50°W 21.48


B. Description of corner evidence found and/or method applied in restoring or reestablishing corner:

October 1994 Arleth found concrete monument at corner.  
found concrete monuments 33.0' East and 33.0' West.  
Found blased wit: of cavanagh 1993 survey all in place.  
Found wit: Tag #21273 in 28" W. pine S5 W 39.50.

C. Description of monument for corner and accessories established to perpetuate locating the position of the corner:

Used Concrete monument as found, placed cap #21266  
Wit: N & T 16" R. pine N17°W 46.75  
N & T 9" Balsam N14°E 22.88  
N & T 5" Maple S13°E 10.25  
N & T 5" Maple S67°E 13.24  
N & T 4" Maple N50°W 21.70  
N & T # 21273 28" W. pine S5°W 21.70  
Concrete monuments 33.0' East & West.

Set caronite post at corner.

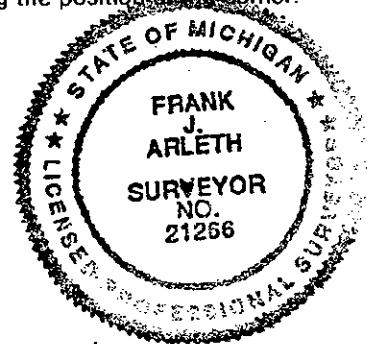

Signed by Frank J. Arleth  
Surveyor's Michigan License No. 21266 P.S.

Date 11/11/94

FORM APPROVED BY MICHIGAN STATE BOARD OF LAND SURVEYORS, JAN. 28, 1971  
REVISED MAY 14, 1975  
REVISED JAN., 1983

DATE 11/10/94 Peer Group Approved  
**LIBER 3 PAGE 160**