

**SURVEY &  
REMONUMENTATION**

**APR 07 1998**

**9232SECTION**

**LAND CORNER RECORDATION CERTIFICATE**  
Filing Requirement of Act 74, Mich P.A. 1970

STATE OF MICHIGAN  
ROSCOMMON COUNTY  
RECORDED

16 DEC 97 12:21 P.M.

ROBERT W. SMITH  
REGISTER OF DEEDS

For corners in  
Roscommon County

Located in: Corner Code #

1. Public Land Survey

T23N	R 1W	G-13
T22N	R 1W	G-1
T	R	
T	R	

**FILE IN LIBER 3 OF LAND CORNERS**  
Register of Deeds Stamp & File Number

I, Larry L. Cavanagh, in a field survey November, 1997, do hereby certify that under requirements of P.A. 74, Michigan P.A. of 1970, the corner points mentioned in line 1 above was in conformance with regulations and rules therefore as required in the current manual of survey instructions of the United States Department of the Interior, Bureau of Land Management or by a decree of a Court of Law, established, re-established, monumented, recovered, found as expressed below:

**A. Description of original monument and accessories and/or subsequent restoration:**

JOHN BRINK 1838  
SET POST  
WHITE PINE 11 N71 1/2E 62  
YELLOW PINE 14 N47W 35

NORMAN C. CALDWELL 12018 1966  
FD 1" PIPE AS SET BY G. HENNING FROM  
ORIG. SURVEY BEARING TREE  
N35°E 43.47 11" OAK (NBT)  
N18°E 80.54 15" TW OAK  
N27°W 81.53 14" OAK  
N47°W 46.50 9" OAK (NBT)  
S45°E 46.20 24" W. PINE STUMP (ORIG. BT)

WILLIAM BURT 1852  
Y. PINE 14 S56W 22 LKS  
W. PINE 24 S45E 70 LKS

GEORGE D. HENNING 1947  
ORIG. US SURVEY CORNER  
FD US BT  
24" W. PINE STP S45°E 46.2 (US BT)  
9" B. OAK N35°E 43.3 (N BT)  
8" B. OAK N47W 46.4 (N BT)  
1" X 24" PIPE IN CORNER

1970'S L2 P147  
1" PIPE  
N35°E 43.47 11" OAK  
N18°E 80.54 15" TW OAK  
N27°W 81.53 14" OAK  
N47°W 46.50 9" OAK (NBT)  
S45°E 46.20 24" W. PINE STUMP

	A	B	C	D	E	F	G	H	I	J	K	L	M
2	6	5	4	3	2	1							
3													
4	7	8	9	10	11	12							
5													
6	18	17	16	15	14	13							
7													
8	19	20	21	22	23	24							
9													
10	30	29	28	27	26	25							
11													
12	31	32	33	34	35	36							

**B. Description of corner evidence found and/or method applied in restoring or reestablishing corner:**

FOUND PAVEMENT BOX, NO MONUMENT  
(E-13 TO F-13) MSHD N89°44'44"W 2648.76', MEASURED N89°44'52"W 2648.97'  
(F-13 TO G-13) MSHD N89°44'44"W 2648.76', MEASURED N89°44'30"W 2648.85'


**C. Description of monument for corner and accessories established to perpetuate locating the position of the corner:**

SET ROSCOMMON COUNTY MONUMENT STAMPED 17614, 1997  
NAIL & TAG IN 20" R. OAK N48°W 63.64'  
NAIL & TAG IN 6" R. OAK N21°E 80.24'  
NAIL & TAG IN 4" W. OAK S37°E 60.60'  
NAIL & TAG IN 5" W. PINE S69°W 156.04'  
CARSONITE POST NORTH 19.2'

A PERPETUATION OF THE ORIGINAL GOVERNMENT CORNER.

**ROSCOMMON COUNTY  
PEER GROUP APPROVAL  
DATE Dec 5, 1997**

*Marvin E. Myers*  
Marvin E. Myers, P.S.  
County Surveyor

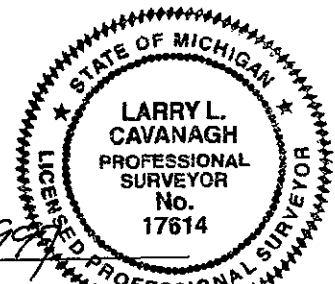

Signed by *Larry L. Cavanagh*  
Surveyor's Michigan License NO. 17614

Date Dec. 11, 1997

FORM APPROVED BY MICHIGAN STATE BOARD OF LAND SURVEYORS, JAN 28, 1971  
REVISED MAY 14, 1975  
REVISED JAN., 1983

**LIBER 3 PAGE 457**