

# SURVEY & REMONUMENTATION

8375 APR 24 1995 ROSCOMMON COUNTY REMONUMENTATION

## LAND CORNER RECORDATION CERTIFICATE COMMISSION Filing Requirement of Act 74, Mich. P.A. 1970

STATE OF MICHIGAN  
ROSCOMMON COUNTY  
RECORDED

15 NOV 94 9:14 A.M.

ROBERT W. SMITH  
REGISTER OF DEEDS

TO BE FILED IN LIBER 3 OF LAND CORNERS

**Register of Deeds Stamp & File Number**

For corners in  
Roscommon  
(County)

Located In: \_\_\_\_\_ Corner Code # \_\_\_\_\_

1. Public Land Survey	T <u>23</u> R <u>1</u> W	<u>H-8</u>
	T _____ R _____	_____
	T _____ R _____	_____
	T _____ R _____	_____
2. Property Controlling in Section	S _____ T _____ R _____	_____
	S _____ T _____ R _____	_____
3. Miscellaneous Property in Sec.	S _____ T _____ R _____	_____
	S _____ T _____ R _____	_____

4. Lot No. \_\_\_\_\_, Recorded Plat \_\_\_\_\_

5. Private Claims \_\_\_\_\_


	A	B	C	D	E	F	G	H	I	J	K	L	M
2	6	5	4	3	2	1							
3													
4	7	8	9	10	11	12							
5													
6	18	17	16	15	14	13							
7													
8	19	20	21	22	23	24							
9													
10	30	29	28	27	26	25							
11													
12	31	32	33	34	35	36							
13													

I, Frank J. Arleth, in a field survey on November, 19 94, do hereby certify that under requirements of P.A. 74, Michigan P.A. of 1970, the corner points mentioned in lines 1 and 2 above were in conformance with regulations and rules therefore as required in the current manual of survey instructions of the United States Department of the Interior, Bureau of Land Management or by a decree of a Court of Law and/or that the corner points mentioned in lines 3, 4 and 5 above were in conformance with the rules of the Michigan Board of Land Surveyors or by a Decree of a Court of Law; established, re-established, monumented, re-monumented, recovered, found as expressed below:

**NOTE: Not more than 4 corners, all in the same town and range, may be recorded on this certificate.**

A. Description of original monument and accessories and/or subsequent restoration:  
 1945 Henning & Ostling set 4" squared pos on South line of Lakeview park 2640.0' West of E.  $\frac{1}{4}$  corner .  
 Ostline 1971 plat of Tippedy Beach Li. 6 P. 78. used for P.O.B.

B. Description of corner evidence found and/or method applied in restoring or reestablishing corner:  
 Arleth November 1994 Found concrete plat monuments set for center of section 27 in 1971 survey by Ostling. Found  $\frac{1}{2}$ " bar 1.8' N89 47'E on  $\frac{1}{4}$  line lot corner for lots 5 & 6, Blk 30 Lakeview Park. Found plat monument 48.04' West of corner.

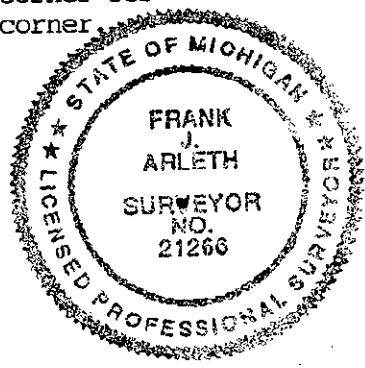

C. Description of monument for corner and accessories established to perpetuate locating the position of the corner:  
 Used concrete plat monument & cap with # 21266 H-8  
 N & T 10 W. Oak N44°E 67.00  
 N & T 40 Twn. B. Oak N51°W 61.82  
 N & T 36" B. oak S35°W 83.24  
 N & T 26" B. oak S39°E 24.55  
 Concrete monument W 48.04'  
 Carsonite post S34°E 17.0'

NOTE: East  $\frac{1}{4}$  corner is 2640' East of corner(H-8) . South  $\frac{1}{4}$  corner is 2653.65' South of corner(H-8)

Signed by Frank J. Arleth Date 11/11/94  
 Surveyor's Michigan License No. 21266 P. S.