

**SURVEY & REMONUMENTATION**

APR 24 1995

**ROSCOMMON COUNTY REMONUMENTATION  
LAND CORNER RECORDATION CERTIFICATE  
COMMISSION Filing Requirement of Act 74, Mich. P.A. 1970**

STATE OF MICHIGAN  
ROSCOMMON COUNTY  
RECORDED

For corners in  
Roscommon  
(County)

Located In:	Corner Code
T <u>23</u> R <u>1</u> W	H-9
T _____ R _____	_____
T _____ R _____	_____
T _____ R _____	_____
T _____ R _____	_____
S _____ T _____ R _____	_____
S _____ T _____ R _____	_____
S _____ T _____ R _____	_____
S _____ T _____ R _____	_____

15 NOV 94 9:14 A.M.

ROBERT W. SMITH  
REGISTER OF DEEDS

TO BE FILED IN LIBER 3 OF LAND CORNERS  
Register of Deeds Stamp & File Number

4. Lot No. \_\_\_\_\_, Recorded Plat \_\_\_\_\_  
5. Private Claims \_\_\_\_\_

	A	B	C	D	E	F	G	H	I	J	K	L	M
2	6	5	4	3	2	1							
3													
4	7	8	9	10	11	12							
5													
6	18	17	16	15	14	13							
7													
8	19	20	21	22	23	24							
9													
10	30	29	28	27	26	25							
11													
12	31	32	33	34	35	36							
13													

I, Frank J. Arleth, in a field survey on November, 19 94, do hereby certify that under requirements of P.A. 74, Michigan P.A. of 1970, the corner points mentioned in lines 1 and 2 above were in conformance with regulations and rules therefore as required in the current manual of survey instructions of the United States Department of the Interior, Bureau of Land Management or by a decree of a Court of Law and/or that the corner points mentioned in lines 3, 4 and 5 above were in conformance with the rules of the Michigan Board of Land Surveyors or by a Decree of a Court of Law; established, re-established, monumented, re-monumented, recovered, found as expressed below:


**NOTE: Not more than 4 corners, all in the same town and range, may be recorded on this certificate.**

A. Description of original monument and accessories and/or subsequent restoration:  
 William Burt set Post 1852  
 S. pine 10" West 35 Lks  
 S. pine 10" N45°E 7 Lks  
 1955 Henninc used corner in Plat of Oakwood 1st addition L. 3 P. 73  
 1944 Henning & Ostling set 1/2" bar for Section subdivision of Sec. 22  
 Wit: Spike 6" B. Oak N36°E 52.2  
 Spike 6" J. pine S47°W 67.3

R.C.R.C. found 1/2" bar  
 Wit: 6" B. Oak S36°E 52.2  
 6" J. pine N36°W 49.7  
 Pav't box centerline of Lake & Airport Roads.

B. Description of corner evidence found and/or method applied in restoring or reestablishing corner:  
 October 1994 Arleth found 1/2" x 16" bar in monument box  
 Wit: 6" B. Oak N36°E 52.2 (gone)  
 6" J. pine S47°W 67.3 (gone)  
 Found conc. monument 33' S & 25' East  
 Found concrete monument 33' S & 25' West  
 Both monuments in plat of Oakwood 1st addition.

C. Description of monument for corner and accessories established to perpetuate locating the position of the corner:  
 Set Roscommon County Standard monument in Pav't box H-9  
 N & T P. pole S31°30'E 37.60  
 N & T 8" B. Oak N12°W 89.60  
 N & T 12" B. Oak N37°E 54.95  
 N & T 12" Twn B. oak N53°E 69.15  
 N & T 14" N. pine S67°W 122.25  
 Set carsonite survey post S31°30'E by power pole

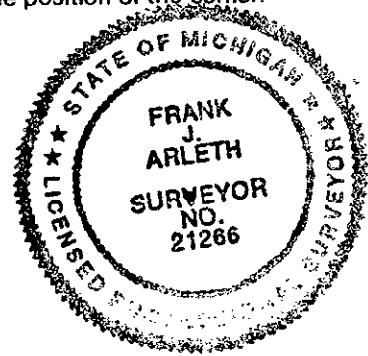

Signed by [Signature] Date 11/11/94  
 Surveyor's Michigan License No. 21266 P.S.

FORM APPROVED BY MICHIGAN STATE BOARD OF LAND SURVEYORS, JAN. 28, 1971  
 REVISED MAY 14, 1975  
 REVISED JAN., 1983

DATE 11/16/94 Peer Group Approved

MEM LIBER 3 PAGE 156