

8377 SURVEY & REMONUMENTATION

APR 24 1995 ROSCOMMON COUNTY REMONUMENTATION
 LAND CORNER RECORDATION CERTIFICATE
 Filing Requirement of Act 74, Mich. P.A. 1970
 COMMISSION

STATE OF MICHIGAN
 ROSCOMMON COUNTY
 RECORDED

15 NOV 94 9:14 A.M.

ROBERT W. SMITH
 REGISTER OF DEEDS

For corners in
 Roscommon
 (County)

Located In: Corner Code ##

1. Public Land Survey	T	23	R	1	W	H-10
	T		R			
	T		R			
	T		R			
2. Property Controlling in Section	S		T		R	
	S		T		R	
3. Miscellaneous Property in Sec.	S		T		R	
	S		T		R	

TO BE FILED IN LIBER 3 OF LAND CORNERS

Register of Deeds Stamp & File Number

4. Lot No. _____, Recorded Plat _____
 5. Private Claims _____


	A	B	C	D	E	F	G	H	I	J	K	L	M
2	6		5		4		3		2		1		
3													
4	7		8		9		10		11		12		
5													
6	18		17		16		15		14		13		
7													
8	19		20		21		22		23		24		
9													
10	30		29		28		27		26		25		
11													
12	31		32		33		34		35		36		
13													

I, Frank J. Arleth, in a field survey on November, 19 94, do hereby certify that under requirements of P.A. 74, Michigan P.A. of 1970, the corner points mentioned in lines 1 and 2 above were in conformance with regulations and rules therefore as required in the current manual of survey instructions of the United States Department of the Interior, Bureau of Land Management or by a decree of a Court of Law and/or that the corner points mentioned in lines 3, 4 and 5 above were in conformance with the rules of the Michigan Board of Land Surveyors or by a Decree of a Court of Law; established, re-established, monumented, re-monumented, recovered, found as expressed below:

NOTE: Not more than 4 corners, all in the same town and range, may be recorded on this certificate.

A. Description of original monument and accessories and/or subsequent restoration:
 Henning set 4" x 4" Oak post in 1944, during section subdivision of sec. 27. Jan. 1958 Ostling set 1/2" x 24" bar at Center of section as established by Henning. Corner set for unrecorded Plat of Jack Pine Forest.
 Wit: BT B. Oak 5" N50°30'E 44.9
 BT J pine 7" S50°30'W 61.7
 1971 Henning
 Henning 1965 recorded Plat of Forton's Oakwood Subdivision, L. 5 P. 40 and tied to the Center of Section 27.

B. Description of corner evidence found and/or method applied in restoring or reestablishing corner:
 October 1994 Arleth found 1/2" bar #2240 for center of Section 27. Corner is 8" below surface Northwest of centerline of trails N & S & trail to West. Found concrete mon. for the southeast corner of Forton's Oakwood Subdivision S89°41'W 332.8' as recorded from center of Section.
 Found 14" B. Oak S39°W 42.30' -blazed.

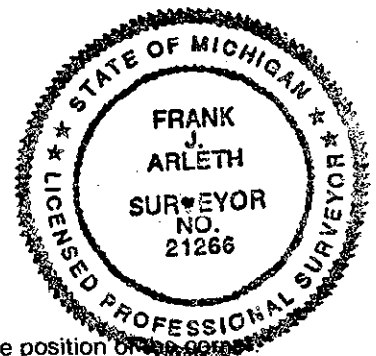

C. Description of monument for corner and accessories established to perpetuate locating the position of corner:
 Set Roscommon County standard monument H-10
 N & T 10" J. pine S72°E 47.16
 N & T 10" J. Pine S32°E 49.20
 N & T 8" J. pine N68°30'E 54.39
 N & T 8" J. pine N6°30'E 51.64
 N & T Power pole S45°W 26.92
 Set Carsonite survey post 5.0 West of corner.
 NOTE: Henning 1944 section subdivision survey
 East 1/4 corner 2661.8' East
 West 1/4 corner 2661.8' West
 North 1/4 corner 2642.4 North & South 1/4 corner is 2642.4 South

Signed by Frank J. Arleth Date 11/11/94
 Surveyor's Michigan License No. 21266 P. S.

FORM APPROVED BY MICHIGAN STATE BOARD OF LAND SURVEYORS, JAN. 28, 1971
 REVISED MAY 14, 1975
 REVISED JAN., 1983

DATE 11/10/94 Peer Group Approved
MEM LIBER 3 PAGE 157