

SURVEY & REMONUMENTATION

8378

APR 24 1995 ROSCOMMON COUNTY REMONUMENTATION

LAND CORNER RECORDATION CERTIFICATE COMMISSION

Filing Requirement of Act 74, Mich. P.A. 1970

STATE OF MICHIGAN
ROSCOMMON COUNTY
RECORDED

15 NOV 94 9:14 A.M.

ROBERT W. SMITH
REGISTER OF DEEDS

For corners in

Roscommon <small>(County)</small>	Located In:	Corner Code #
1. Public Land Survey	T <u>23</u> R <u>1</u> W	H-11
	T _____ R _____	_____
	T _____ R _____	_____
	T _____ R _____	_____
2. Property Controlling in Section	S _____ T _____ R _____	_____
	S _____ T _____ R _____	_____
3. Miscellaneous Property in Sec.	S _____ T _____ R _____	_____
	S _____ T _____ R _____	_____
4. Lot No. _____, Recorded Plat _____		
5. Private Claims _____		

TO BE FILED IN LIBER 3 OF LAND CORNERS

Register of Deeds Stamp & File Number

	A	B	C	D	E	F	G	H	I	J	K	L	M
2	6		5		4		3		2		1		
3													
4	7		8		9		10		11		12		
5													
6	18		17		16		15		14		13		
7													
8	19		20		21		22		23		24		
9													
10	30		29		28		27		26		25		
11								⊙					
12	31		32		33		34		35		36		
13													

I, Frank J. Arleth in a field survey on November, 1994, do hereby certify that under requirements of P.A. 74, Michigan P.A. of 1970, the corner points mentioned in lines 1 and 2 above were in conformance with regulations and rules therefore as required in the current manual of survey instructions of the United States Department of the Interior, Bureau of Land Management or by a decree of a Court of Law and/or that the corner points mentioned in lines 3, 4 and 5 above were in conformance with the rules of the Michigan Board of Land Surveyors or by a Decree of a Court of Law; established, re-established, monumented, re-monumented, recovered, found as expressed below:

NOTE: Not more than 4 corners, all in the same town and range, may be recorded on this certificate.

A. Description of original monument and accessories and/or subsequent restoration:

William Burt set post 1852	Henning 1966, recorded Plat of Sharon
S. Pine 12" N89°E 21 Lks	acres Li 5 P 60. S½ corner Section 27 is
S. Pine 8" S76°W 10 Lks	N89 47'W 332.4'; thence S0 04'E 33.0'
	from P. O. B for Sharon Acres.
Henning & Ostling 1944 in a section subdivision set 3/4" x 24" pine	R. C. R.C. Found 3/4" pine
J. pine 8" N23°E 95.2	8" J.pine North 75.2
J. Pine 4" S37°E 62.6	8" J. pine S37°E 62.6

B. Description of corner evidence found and/or method applied in restoring or reestablishing corner:

October 1994 Arleth found 3/4" pipe 3.5 South of centerline of Artesia Beach Road.

Found Henning Wit: set 1944

8" J. pine (dead S37°E 62.6

12" J. pine (stump) N23°E 95.2

R. C. R. C. Wit: 8" J.pine North 75.2 destroyed.

C. Description of monument for corner and accessories established to perpetuate locating the position of the corner:

Set Roscommon County Standard Monument. H-11

Wit: N & T 10" J. pine S24°E 60.94


N & T 8" J. pine S55°E 83.51

N & T power pole S48°W 31.36

N & T 10" J. pine N40°E 71.28

N & T 10" B. Oak N41°W 71.60

Set carsonite survey post South 37.0

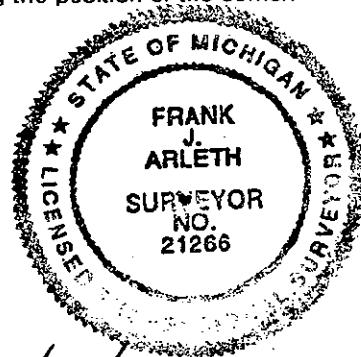

Signed by [Signature] Date 11/11/94

Surveyor's Michigan License No. 21266

DATE 11/10/94 Peer Group Approved

LIBER 3 PAGE 158