

8384

SURVEY & REMONUMENTATION

ROSCOMMON COUNTY REMONUMENTATION

APR 24 1995 **LAND CORNER RECORDATION CERTIFICATE**

Filing Requirement of Act 74, Mich. P.A. 1970

For corners in

COMMISSION

ROSCOMMON Located In: Corner Code #
(County)

15 NOV 1994 R.M.

- 1. Public Land Survey T 23 R 1 W I-12
T _____ R _____
T _____ R _____
T _____ R _____
- 2. Property Controlling S _____ T _____ R _____
in Section S _____ T _____ R _____
- 3. Miscellaneous S _____ T _____ R _____
Property in Sec. S _____ T _____ R _____
- 4. Lot No. _____, Recorded Plat _____
- 5. Private Claims _____

TO BE FILED IN LIBER 3 OF LAND CORNERS

Register of Deeds Stamp & File Number

I, FRANK J. ARLETH, in a field survey on NOVEMBER, 19 94, do hereby certify that under requirements of P.A. 74, Michigan P.A. of 1970, the corner points mentioned in lines 1 and 2 above were in conformance with regulations and rules therefore as required in the current manual of survey instructions of the United States Department of the Interior, Bureau of Land Management or by a decree of a Court of Law and/or that the corner points mentioned in lines 3, 4 and 5 above were in conformance with the rules of the Michigan Board of Land Surveyors or by a Decree of a Court of Law; established, re-established, monumented, re-monumented, recovered, found as expressed below:

A	B	C	D	E	F	G	H	I	J	K	L	M
2	6	5	4	3	2	1						
3												
4	7	8	9	10	11	12						
5												
6	18	17	16	15	14	13						
7												
8	19	20	21	22	23	24						
9												
10	30	29	28	27	26	25						
11												
12	31	32	33	34	35	36						
13												

NOTE: Not more than 4 corners, all in the same town and range, may be recorded on this certificate.

A. Description of original monument and accessories and/or subsequent restoration:

WILLIAM BURT SET POST 1852
S. PINE 7" S63°W, 9 LKS.
S. PINE 6" N20°E, 21 LKS.


HENNING AND OSTLING 1944
SET 1" X 24" PIPE IN CORNER
MKD. 10" J. PINE N60°E, 52.5'
MKD. 14" J. PINE S68°30'W, 48.3'

B. Description of corner evidence found and/or method applied in restoring or reestablishing corner:

ARLETH NOV. 1994
FOUND 1" X 24" PIPE IN PAV'T. BOX
2.50' EAST OF CENTERLINE OF M-76
FOUND OLD. BT. 16" J. PINE N60°E, 52.50' (G.D.H. 1944).

C. Description of monument for corner and accessories established to perpetuate locating the position of the corner:

SET ROSCOMMON COUNTY STANDARD MONUMENT IN PAV'T. BOX I-12
N&T 14" B. OAK N71°W, 70.42'
N&T 6" N. PINE N38°W, 75.40'
N&T 8" N. PINE N40°E, 67.98'
N&T POWER POLE EAST, 35.51'
N&T 14" J. PINE S25°E, 110.90'
NE. COR. OF BLOCK BUILDING S80°W, 66.45'
SET CARSONITE SURVEY POST N38°W, 62.00'

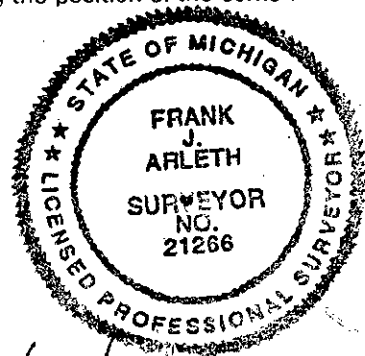

Signed by [Signature] Date 11/16/94
Surveyor's Michigan License No. 21266 P.S.

DATE: 11/10/94 MEM