

APR 24 1995

LAND CORNER RECORDATION CERTIFICATE

Filing Requirement of Act 74, Mich. P.A. 1970

For corners in **COMMISSION**

Roscommon (County) Located In: Corner Code #/

1. Public Land Survey T 23 R 1 W I-13

2. Property Controlling in Section S _____ T _____ R _____

3. Miscellaneous Property in Sec. S _____ T _____ R _____

4. Lot No. _____, Recorded Plat _____

5. Private Claims _____

15 NOV 87 9:13 A.M.

TO BE FILED IN LIBER 3 OF LAND CORNERS

Register of Deeds Stamp & File Number

I, Frank J. Arleth in a field survey on November, 19 94, do hereby certify that under requirements of P.A. 74, Michigan P.A. of 1970, the corner points mentioned in lines 1 and 2 above were in conformance with regulations and rules therefore as required in the current manual of survey instructions of the United States Department of the Interior, Bureau of Land Management or by a decree of a Court of Law and/or that the corner points mentioned in lines 3, 4 and 5 above were in conformance with the rules of the Michigan Board of Land Surveyors or by a Decree of a Court of Law; established, re-established, monumented, re-monumented, recovered, found as expressed below:

A	B	C	D	E	F	G	H	I	J	K	L	M
2	6	5	4	3	2	1						
3												
4	7	8	9	10	11	12						
5												
6	18	17	16	15	14	13						
7												
8	19	20	21	22	23	24						
9												
10	30	29	28	27	26	25						
11												
12	31	32	33	34	35	36						
13												

NOTE: Not more than 4 corners, all in the same town and range, may be recorded on this certificate.


A. Description of original monument and accessories and/or subsequent restoration:

WILLIAM BURT SET POST 1852 STATE HIGHWAY DEPARTMENT
 SET PAV'T. BOX
 N&T POWER POLE N47°30'E, 71.81' (OK)
 N&T POWER POLE S40°W, 65.98' (OK)

HENNING AND OSTLING 1944
 SET PIPE AND POST
 MKD. 8" N. PINE N42°E, 52.4'
 MKD. 18" B. OAK N46°30'W, 68.0'

B. Description of corner evidence found and/or method applied in restoring or reestablishing corner:

ARLETH 1994
 FOUND 1" X 24" PIPE IN PAV'T. BOX
 IN CENTERLINE OF M-76 AND ROADS EAST AND WEST
 WIT. N&T POWER POLE N47°30'E, 71.81' (OK)
 WIT. N&T POWER POLE S40°W, 65.98' (OK)
 FOUND N&T IN 4" B. OAK S29°E, 103.40'
 FOUND N&T IN 8" J. PINE N40°W, 98.51'

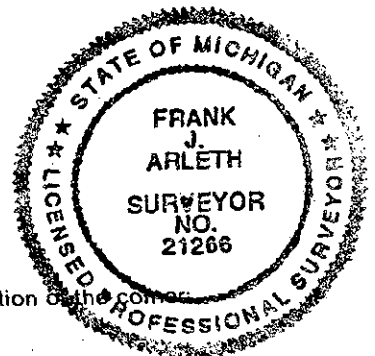

C. Description of monument for corner and accessories established to perpetuate locating the position of the corner:

SET ROSCOMMON COUNTY STAND MONUMENT IN PAV'T. BOX I-13
 N&T 16" W. PINE N44°30'E, 119.34'
 N&T 16" W. PINE S68°E, 122.54'
 N&T 10" J. PINE N46°30'W, 104.55'
 N&T POWER POLE N47°30'E, 71.81'
 N&T 4" B. OAK S29°E, 103.40'
 N&T POWER POLE S40°W, 65.98'
 N&T 8" J. PINE N40°W, 98.51'

SET CARSONITE POST N40°W, 67.00'

Signed by Frank J. Arleth
 Surveyor's Michigan License No. 21266 P.S.

Date 11/16/94

DATE: 11/10/94 *MA*