

**SURVEY &
REMONUMENTATION**

APR 07 1998

SECTION

9230

LAND CORNER RECORDATION CERTIFICATE
Filing Requirement of Act 74, Mich P.A. 1970

STATE OF MICHIGAN
ROSCOMMON COUNTY
RECORDED

For corners in
Roscommon County

Located in: Corner Code #

1. Public Land Survey

T23N	R1W	J-13
T22N	R1W	J-1
T	R	
T	R	

16 DEC 97 12:20 P.M.

ROBERT W. SMITH
REGISTER OF DEEDS

FILE IN LIBER 3 OF LAND CORNE
Register of Deeds Stamp & File Number

I, Larry L. Cavanagh, in a field survey November, 1997, do hereby certify that under requirements of P.A. 74, Michigan P.A. of 1970, the corner points mentioned in line 1 above was in conformance with regulations and rules therefore as required in the current manual of survey instructions of the United States Department of the Interior, Bureau of Land Management or by a decree of a Court of Law; established, re-established, monumented, recovered, found as expressed below:

A. Description of original monument and accessories and/or subsequent restoration:

JOHN BRINK 1838 SET POST PITCH PINE 10" N65E 42LKS PITCH PINE 10" N61 1/2W 24 LKS	1970'S L2 P323 1"X24" PIPE & B. OAK POST N45°W 79.2' 9" B. OAK N53°E 57.4' 5" B. OAK
GEORGE HENNING 1944 SET 1" X 24" PIPE 9" B. OAK N45°W 79.2' 5" B. OAK N53°E 57.4'	FRANK J. ARLETH 21266 1990 FD 1" PIPE WIT: 12" B. OAK N45°W 79.8' 10" B. OAK N53°E 57.4'

	A	B	C	D	E	F	G	H	I	J	K	L	N
2	6	5	4	3	2	1							
3													
4	7	8	9	10	11	12							
5													
6	18	17	16	15	14	13							
7													
8	19	20	21	22	23	24							
9													
10	30	29	28	27	26	25							
11													
12	31	32	33	34	35	36							
13													

B. Description of corner evidence found and/or method applied in restoring or reestablishing corner:

FOUND 1" X 24" PIPE
9" B. OAK N45°W 79.20'
5" B. OAK (NOW STUMP) N53°E 57.4'

C. Description of monument for corner and accessories established to perpetuate locating the position of the corner:

SET ROSCOMMON COUNTY MONUMENT STAMPED 17614, 1997
NAIL & TAG IN 8" JACK PINE S06°W 23.57'
NAIL & TAG IN 7" JACK PINE S44°W 33.29'
NAIL & TAG IN 9" NORWAY PINE N06°E 69.68'
NAIL & TAG IN 17" B. OAK N45°W 79.2'
CARSONITE POST S02°W 3.9'

THE BEST AVAILABLE EVIDENCE OF THE POSITION OF THE ORIGINAL CORNER.

**ROSCOMMON COUNTY
PEER GROUP APPROVAL**


DATE Dec 6, 1997

Marvin E. Myers

Marvin E. Myers, P.S.
County Surveyor

Signed by Larry L. Cavanagh
Surveyor's Michigan License NO. 17614

Date Dec 11, 1997

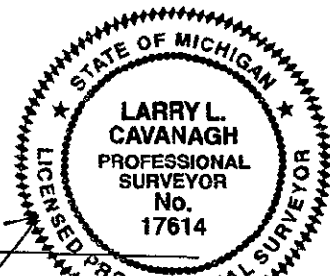

FORM APPROVED BY MICHIGAN STATE BOARD OF LAND SURVEYORS JAN 28, 1971
REVISED MAY 14, 1975
REVISED JAN., 1983

LIBER 3 PAGE 455