

9256 19 394

ROSCOMMON COUNTY REMONUMENTATION

STATE OF MICHIGAN  
COUNTY OF ROSCOMMON

LAND CORNER RECORDATION CERTIFICATE  
Filing Requirement of Act 74, Mich. P.A. 1970

DEC 28 10 47 AM '93

For corners in  
Roscommon  
(County)

Located In: Corner Code #

1. Public Land Survey	T	23	R	1	W	K - 7
	T		R			
	T		R			
	T		R			
2. Property Controlling in Section	S		T		R	
	S		T		R	
3. Miscellaneous Property in Sec.	S		T		R	
	S		T		R	

REGISTERED  
**ROSCOMMON COUNTY  
PEER GROUP APPROVAL  
DATE 12-14-93**

Register of Deeds Stamp & File Number

- 4. Lot No. \_\_\_\_\_, Recorded Plat \_\_\_\_\_
- 5. Private Claims \_\_\_\_\_

A	B	C	D	E	F	G	H	I	J	K	L	M
2	6	5	4	3	2	1						
3												
4	7	8	9	10	11	12						
5												
6	18	17	16	15	14	13						
7												
8	19	20	21	22	23	24						
9												
10	30	29	28	27	26	25						
11												
12	31	32	33	34	35	36						
13												

I, Frank J. Arleth, in a field survey on December, 1993, do hereby certify that under requirements of P.A. 74, Michigan P.A. of 1970, the corner points mentioned in lines 1 and 2 above were in conformance with regulations and rules therefore as required in the current manual of survey instructions of the United States Department of the Interior, Bureau of Land Management or by a decree of a Court of Law and/or that the corner points mentioned in lines 3, 4 and 5 above were in conformance with the rules of the Michigan Board of Land Surveyors or by a Decree of a Court of Law; established, re-established, monumented, re-monumented, recovered, found as expressed below:

**NOTE: Not more than 4 corners, all in the same town and range, may be recorded on this certificate.**

A. Description of original monument and accessories and/or subsequent restoration:


William Burt set post 1852  
Y. Pine 24" N22°W 163 Lks.  
Maple 12" S30°E 90 Lks.

B. Description of corner evidence found and/or method applied in restoring or reestablishing corner:

Found 1 1/4" pipe as set in a section subdivision by Henning in 1954.  
Found witness in place - Arleth 1993  
Witness: 18" Norway N15°W, 138.3 ( now a stump )

C. Description of monument for corner and accessories established to perpetuate locating the position of the corner:

Set Roscommon County Std. Mon. stamped K - 7, corner next to 2" fence post fence line South and West from corner  
Nail & tag in 16" N. Pine S51°W 56.27  
Nail & tag in 8" Maple S61°E 44.28  
Nail & tag in 14" N. Pine N30°E 24.12  
Nail & tag in 8" Maple N35°W 37.95  
Norway N15°W 138.3 stump

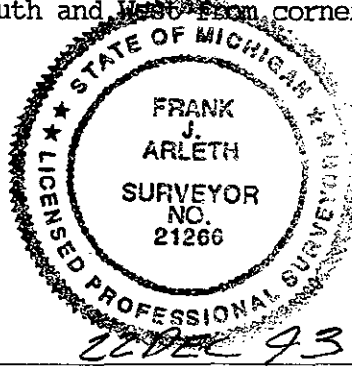

Signed by Frank J. Arleth

Date 22 DEC 93

Surveyor's Michigan License No. 21266

Date December 14, 1993 Peer Group Approved