

9257

FEB 18 1994

ROSCOMMON COUNTY REMONUMENTATION

LAND CORNER RECORDATION CERTIFICATE

Filing Requirement of Act 74, Mich. P.A. 1970

Dec 28 10 47 AM '93

For corners in
Roscommon

Located In: Corner Code #

- 1. Public Land Survey T 23 R 1 W K - 8
T _____ R _____
T _____ R _____
T _____ R _____
- 2. Property Controlling S _____ T _____ R _____
in Section S _____ T _____ R _____
- 3. Miscellaneous S _____ T _____ R _____
Property in Sec. S _____ T _____ R _____

ROSCOMMON COUNTY
PEER GROUP APPROVAL
DATE 12-14-93

Register of Deeds Stamp & File Number

- 4. Lot No. _____, Recorded Plat _____
- 5. Private Claims _____

	A	B	C	D	E	F	G	H	I	J	K	L	M
2	6		5		4		3		2		1		
3													
4	7		8		9		10		11		12		
5													
6	18		17		16		15		14		13		
7													
8	19		20		21		22		23		24		
9													
10	30		29		28		27		26		25		
11													
12	31		32		33		34		35		36		
13													

I, Frank J. Arleth, in a field survey on December, 19 93, do hereby certify that under requirements of P.A. 74, Michigan P.A. of 1970, the corner points mentioned in lines 1 and 2 above were in conformance with regulations and rules therefore as required in the current manual of survey instructions of the United States Department of the Interior, Bureau of Land Management or by a decree of a Court of Law and/or that the corner points mentioned in lines 3, 4 and 5 above were in conformance with the rules of the Michigan Board of Land Surveyors or by a Decree of a Court of Law; established, re-established, monumented, re-monumented, recovered, found as expressed below:

NOTE: Not more than 4 corners, all in the same town and range, may be recorded on this certificate.

A. Description of original monument and accessories and/or subsequent restoration:


William Burt Set post 1852
Y. pine 20" S69°W 119 Lks.
Y. pine 20" N19°E 14 Lks.

B. Description of corner evidence found and/or method applied in restoring or reestablishing corner:

East 1/4 corner of Section 23, T23N, R1W., found concrete mon. set by Henning for the Plat of CEDAR CREEK SUBDIVISION (5/22/57)
Witness set by Henning 1959 are still in place
8" B. Oak S2°E 58.7
8" B. Oak N81°W 34.8

C. Description of monument for corner and accessories established to perpetuate locating the position of the corner:

Used concrete mon. with cap # 21266
Nail & tag 10" J. Pine N16°E 36.11
Nail & tag 10" J. Pine S82°E 32.91
Nail & tag 12" J. Pine S49°W 55.20
Nail & tag 8" J. Pine N38°W 31.62
Set carsonite post 2.0' North of corner

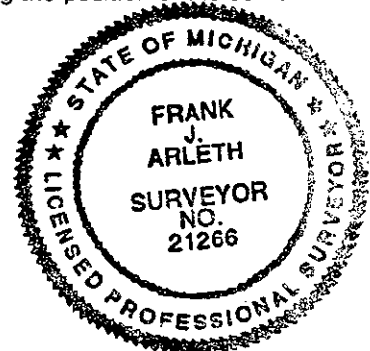

Signed by Frank J. Arleth

Date 22 DEC 93

Surveyor's Michigan License No. 21266

Date December 14, 1993 Peer Group Approved