

MAP SHEET


TOWN 24 N RANGE 1 W

DATE	FILE NO.
DIVISION	DISTRICT
MAPPED BY:	
PHOTO NUMBERS	

COUNTY <u>Roscommon</u>	TOWNSHIP	NUMBER OF ACRES
OWNER OF LAND		PHOTO NUMBERS
PURPOSE OF MAP		

	A	B	C	D	E	F	G	H	I	J	K	L	M
1													
2		6		5		4		3		2		1	
3													
4		7		8		9		10		11		12	
5													
6		18		17		16		15		14		13	
7	9												
8		19		20		21		22		23		24	
9													
10		30		29		28		27		26		25	
11													
12		31		32		33		34		35		36	
13													

REMARKS

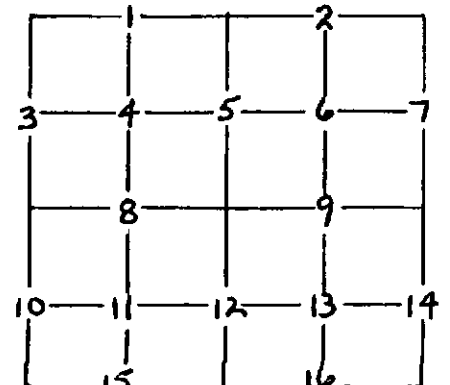

- denotes 2 records