

MICHIGAN
DEPARTMENT OF CONSERVATION
FORESTRY DIVISION

LAND CORNER RECORD

T. 24 N.R. 1 W.
T. 24 N.R. 2 W.


Roscommon COUNTY

DESCRIPTION OF CORNER Section corner common to Sections 18 - 19 - 13 - 24

CORNER MONUMENT Set 1" pipe with 4" brass cap

DATE MONUMENT PLACED AND WITNESSED May 16, 1963

WITNESSES TO CORNER.....

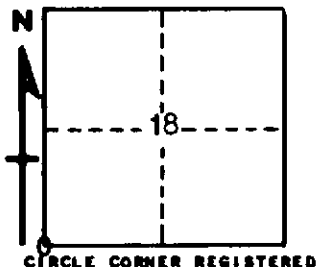

18" W. Pine N 86 E 23.9'

9" Cedar S 43 E 15.5'

AND

7" Cedar S 27 W 21.3'

DESCRIPTION IN DETAIL AS TO HOW CORNER WAS LOCATED AND IDENTIFIED OR RESTORED.

This corner was found while making a corner search in this area. Found old squared post at corner as restored from SE government BT stump which is still in place with good lower face and marks. Remains of the NE Tamarack also in place. Good original corner.

SURVEYOR'S SEAL

SIGNED *Kenneth J. Osting* DATE June 24, 1963
REGISTERED AND SURVEYOR #10868