

FEB 18 1994

STATE OF MICHIGAN  
COUNTY OF ROSCOMMON  
REGISTERED

9260 COMMISSION

DEC 28 10 47 AM '93

**LAND CORNER RECORDATION CERTIFICATE**  
**Filing Requirement of Act 74, Mich. P.A. 1970**

For corners in

Roscommon  
(County)

Located In:

Corner Code #

- |                                    |   |           |   |          |       |              |
|------------------------------------|---|-----------|---|----------|-------|--------------|
| 1. Public Land Survey              | T | <u>24</u> | R | <u>1</u> | W     | <u>A - 3</u> |
|                                    | T | _____     | R | _____    | _____ | _____        |
|                                    | T | _____     | R | _____    | _____ | _____        |
|                                    | T | _____     | R | _____    | _____ | _____        |
| 2. Property Controlling in Section | S | _____     | T | _____    | R     | _____        |
|                                    | S | _____     | T | _____    | R     | _____        |
| 3. Miscellaneous Property in Sec.  | S | _____     | T | _____    | R     | _____        |
|                                    | S | _____     | T | _____    | R     | _____        |

*Robert H. ...*  
REGISTERED

**ROSCOMMON COUNTY**  
**PEER GROUP APPROVAL**  
**DATE 12-14-93**

Register of Deeds Stamp & File Number

4. Lot No. \_\_\_\_\_, Recorded Plat \_\_\_\_\_
5. Private Claims \_\_\_\_\_

A	B	C	D	E	F	G	H	I	J	K	L	M
2	6	5	4	3	2	1						
3												
4	7	8	9	10	11	12						
5												
6	18	17	16	15	14	13						
7												
8	19	20	21	22	23	24						
9												
10	30	29	28	27	26	25						
11												
12	31	32	33	34	35	36						
13												

I, Frank J. Arleth, in a field survey on December, 19 93, do hereby certify that under requirements of P.A. 74, Michigan P.A. of 1970, the corner points mentioned in lines 1 and 2 above were in conformance with regulations and rules therefore as required in the current manual of survey instructions of the United States Department of the Interior, Bureau of Land Management or by a decree of a Court of Law and/or that the corner points mentioned in lines 3, 4 and 5 above were in conformance with the rules of the Michigan Board of Land Surveyors or by a Decree of a Court of Law; established, re-established, monumented, re-monumented, recovered, found as expressed below:

**NOTE: Not more than 4 corners, all in the same town and range, may be recorded on this certificate.**

A. Description of original monument and accessories and/or subsequent restoration:


**William Burt Set post in North edge of stream 70 Lks. wide and runs NW  
Willow 7" S40°W 28 Lks.  
No other tree in area**

B. Description of corner evidence found and/or method applied in restoring or reestablishing corner:

**1946 Henning found no evidence of corner in true position, said wild corner set by Richardson was 48.5 West & 14.6 North of true position for corner. 1949 Henning set post for corner. 1964 Ostling set 5/8" bar in Henning post. Wit: 8" Elm N20 W 4.2. Found 5/8" bar set by Ostling, also post 3.0 South of corner. Wit: 8" Elm dying. River ties East 16.0', South 20', West 30'**

C. Description of monument for corner and accessories established to perpetuate locating the position of the corner:

**Set Roscommon County Std. Mon stamped M-3  
Nail & tag 16" Elm N20°W 25.82  
Nail & tag 12" Elm N55° W 20.25  
Nail & tag 16" Elm N20°W 3.85 - 1964  
Nail & tag 16" Elm stump East 15.2  
Carsonite Post Next to corner.**

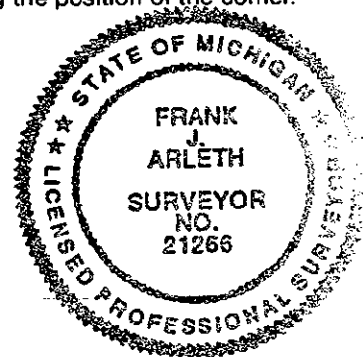

Signed by Frank J. Arleth Date 27 DEC 93  
Surveyor's Michigan License No. 21266

FORM APPROVED BY MICHIGAN STATE BOARD OF LAND SURVEYORS, JAN. 28, 1971  
REVISED MAY 14, 1975  
REVISED JAN., 1983

DATE December 14, 1993 PEER GROUP APPROVED

LIBER 3 PAGE 86