

8752

LAND CORNER RECORDATION CERTIFICATE  
Filing Requirement of Act 74, Mich. P.A. 1970

JAN 24 1996

COMMISSION

For corners in

Roscommon  
(County)

Located In:

Corner Code ##

- 1. Public Land Survey T 24 R 1 W SURVEY & RE-MONUMENTATION
- 2. Property Controlling in Section S \_\_\_ T \_\_\_ R \_\_\_ APR 05 1996
- 3. Miscellaneous Property in Sec. S \_\_\_ T \_\_\_ R \_\_\_ COMMISSION

STATE OF MICHIGAN  
ROSCOMMON COUNTY  
RECORDED

19 DEC 95 9:09 A.M.

Register of Deeds Stamp & File Number  
REGISTER OF DEEDS

- 4. Lot No. \_\_\_\_\_, Recorded Plat \_\_\_\_\_
- 5. Private Claims \_\_\_\_\_

I, Frank J. Arleth, in a field survey on March, 19 95, do hereby certify that under requirements of P.A. 74, Michigan P.A. of 1970, the corner points mentioned in lines 1 and 2 above were in conformance with regulations and rules therefore as required in the current manual of survey instructions of the United States Department of the Interior, Bureau of Land Management or by a decree of a Court of Law and/or that the corner points mentioned in lines 3, 4 and 5 above were in conformance with the rules of the Michigan Board of Land Surveyors or by a Decree of a Court of Law; established, re-established, monumented, re-monumented, recovered, found as expressed below:

NOTE: Not more than 4 corners, all in the same town and range, may be recorded on this certificate.

	A	B	C	D	E	F	G	H	I	J	K	L	M
2	6	5	4	3	2	1							
3		0											
4	7	8	9	10	11	12							
5													
6	18	17	16	15	14	13							
7													
8	19	20	21	22	23	24							
9													
10	30	29	28	27	26	25							
11													
12	31	32	33	34	35	36							
13													

A. Description of original monument and accessories and/or subsequent restoration:

William Burt 1852 W. Birch 6" N34°W 11 lks  
 W. Birch 8" S 5°E 8 lks  
 Henning 1958, Survey of the North Fr 1 1/2 of NW Fr 1 1/4 of Section 5 T24N, R1W and established N & S 1/4 line  
 Ostling 1962 remarked N & S 1/4 line over North fr 1 1/4.

Henning 1983 fd. 3/4" pipe for South 1/4 corner of Section 5 T24N, R1W.  
 8" Maple NW 15.55'  
 4" Spruce NE 23.2'  
 Arleth 1988 used Henning cor. on N & S 1/4 line.

B. Description of corner evidence found and/or method applied in restoring or reestablishing corner:

Arleth 1995  
Fd 3/4" pipe  
8" Maple NW 15.55' (gone)  
4" spruce NE 23.3' (down)


ROSCOMMON COUNTY  
PEER GROUP APPROVAL

DATE 12-8-1995

*M.A.M.*

C. Description of monument for corner and accessories established to perpetuate locating the position of the corner:

Set Roscommon County Standard Monument Stamped D-3 21266  
N & T 8" Balsam S28°30'E 19.06'  
N & T 10" Cedar S71°30'E 32.87'  
N & T 8" Balsam N86°30'E 26.00'  
N & T 10" Balsam N56°00'E 13.52'  
N & T 6" Balsam N06°30'W 10.03'  
Set carsonite post 1.0 West of corner.

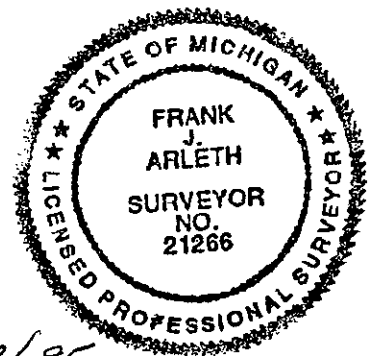

Signed by *Frank J. Arleth*

Date 12/8/95

Surveyor's Michigan License No. 21266

Date 12/8/95

Peer Group Approval

LIBER 3 PAGE 276