

LAND CORNER RECORDATION CERTIFICATE
Filing Requirement of Act 74, Mich P.A. 1970

For corners in
 Roscommon County

1. Public Land Survey

Located in: T24N R1W Corner Code # G-1
T R _____
T R _____
T R _____

STATE OF MICHIGAN
 ROSCOMMON COUNTY
 RECORDED
 6 OCT 1999 11:35:34 AM
 ROBERT W. SMITH
 REGISTER OF DEEDS

I, Larry L. Cavanagh, in a field survey May 1999, do hereby certify that under requirements of P.A. 74, Michigan P.A. of 1970, the corner points mentioned in line 1 above was in conformance with regulations and rules therefore as required in the current manual of survey instructions of the United States Department of the Interior, Bureau of Land Management or by a decree of a Court of Law; established, re-established, monumented, recovered, found as expressed below:

FILE IN LIBER 3 OF LAND CORNERS
 Register of Deeds Stamp & File Number

A. Description of original monument and accessories and/or subsequent restoration:

JOHN BRINK 1839
 SET POST
 PITCH PINE 6" N59°E 36 LKS
 PITCH PINE 6" N47°W 35 LKS

T.N. CANADA 1937
 LOCATION DETERMINED BY STUMP OF AN
 ORIGINAL BEARING TREE
 SET CONC MON 6" DIA X 24" BRASS CAP & STEM
 (REMAINS OF ORIGINAL BEARING TREES)
 J. PINE STUMP 12" N47°W 35 LKS
 (LOCAL BEARING TREES)
 J. PINE 7" N56 1/2°E 91 1/2 LKS
 NORWAY PINE 3" N42 3/4°W 63 1/2 LKS
 (NEW BEARING TREES)
 NORWAY PINE 5" N28 1/2°E 132 LKS
 NORWAY PINE 4" N23 1/2°W 125 LKS

WILLIAM BURT 1852
 FD POST
 S PINE 10" S49°E 30 LKS
 Y. PINE 6" S45°W 25 LKS

LCRC 1970'S L2, P434
 N56°E 60.3' J. PINE
 N43°W 41.8' 3" NORWAY
 N28°E 87.1' 5" NORWAY
 N23°W 82.8' 4" NORWAY

LARRY L. CAVANAGH, 1973
 FD GLO MONUMENT
 N42 3/4°W 41.9' 3" NORWAY (37) 12'(73) 18" (99)
 N28 1/2°E 87.12' 5" NORWAY (37) 18'(73) 18" (99)
 N23 1/2°W 82.83' 4" NORWAY (37) 14'(73) 17"(99)

	A	B	C	D	E	F	G	H	I	J	K	L	M
2	6	5	4	3	2	1							
3													
4	7	8	9	10	11	12							
5													
6	18	17	16	15	14	13							
7													
8	19	20	21	22	23	24							
9													
10	30	29	28	27	26	25							
11													
12	31	32	33	34	35	36							
13													

B. Description of corner evidence found and/or method applied in restoring or reestablishing corner:

FOUND GLO MONUMENT
 13' (NOW 18") NORWAY PINE N42 3/4°W 63 1/2 LKS
 5' (NOW 18") NORWAY PINE N28 1/2°E 132 LKS
 4' (NOW 17") NORWAY PINE N23 1/2°W 125 1/2 LKS
 10" W. PINE S25°W 47.11' LEEMON TAG IN TREE
 9" B OAK S65°E 75.15' LEEMON TAG IN TREE


A PERPETUATION OF THE ORIGINAL GOVERNMENT CORNER.

C. Description of monument for corner and accessories established to perpetuate locating the position of the corner:

LEFT GLO MONUMENT IN PLACE
 WIT: NAIL & TAG IN 18" NORWAY PINE N42 3/4°W 42.05'
 NAIL & TAG IN 18" NORWAY PINE N28 1/2°E 86.70'
 NAIL & TAG IN 17" NORWAY PINE N23 1/2°W 82.99'
 NAIL & TAG IN 10" WHITE PINE S25°W 47.11'
 NAIL & TAG IN 9" BLACK OAK S65°E 75.15'
 CARSONITE POST NORTH 24.8'

ROSCOMMON COUNTY
PEER GROUP APPROVAL
 DATE Sept 10 1999

Marvin E. Myers
Marvin E. Myers, P.S.
 County Surveyor

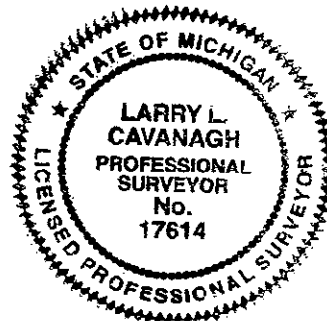

SURVEY &
 RECORDED
 MAR 1 1 2000
 SECTION

Signed by Larry L. Cavanagh Date Sept. 14, 1999
 Surveyor's Michigan License NO. 17614

FORM APPROVED BY MICHIGAN STATE BOARD OF LAND SURVEYORS, JAN 28, 1971
 REVISED MAY 14, 1975
 REVISED JAN., 1983

