


LAND CORNER RECORDATION CERTIFICATE
Filing Requirement of Act 74, Mich P.A. 1970

For corners in Roscommon County

Located in: Corner Code #

1. Public Land Survey

T24N R1W I-1
T R
T R
T R

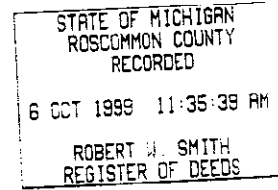

FILE IN LIBER 3 OF LAND CORNERS
Register of Deeds Stamp & File Number

I, Larry L. Cavanagh, in a field survey May 1999, do hereby certify that under requirements of P.A. 74, Michigan P.A. of 1970, the corner points mentioned in line 1 above was in conformance with regulations and rules therefore as required in the current manual of survey instructions of the United States Department of the Interior, Bureau of Land Management or by a decree of a Court of Law; established, re-established, monumented, recovered, found as expressed below:

A. Description of original monument and accessories and/or subsequent restoration:

JOHN BRINK 1839
SET POST
PITCH PINE 6° N30°E 64 LKS
W. OAK 4° N84°W 62 LKS

T.N. CANADA 1937
FD REMAINS OF ORIGINAL B TREES
SET CONC MON 6" DIA X 24" BRASS CAP & STEM
NORWAY PINE ST. 10° N8°E 33 LKS
PINE ST. 10° N30°E 64 LKS
J. PINE ST. 10° N36°W 89 LKS
(LCAL BEARING TREE)
W. OAK 6° N35 3/4°E 77 LKS
J. PINE 7° N47°W 92 LKS
(NEW BEARING TREES)
B OAK 8° N34 1/2°E 92 1/2 LKS
J. PINE 7° N59°W 68 1/2 LKS

WILLIAM BURT
FOUND POST
Y. PINE 5° S78°E 25 LKS
B. OAK 7° S40°W 84 LKS

LCRC 1970S L2, P434
S52°W 98.4' 14" NORWAY
S48°E 113.6' 6" NORWAY
N47°W 60.0' 10" J. PINE
N36°E 50.5' 10" W. OAK
N34 1/2°E 60.7' 11" W. OAK

FRANK ARLETH, RLS 1988
1 1/4" PIPE 3' EAST OF C/L OF RD
6" N. PINE S486E 113.6'
10" J. PINE N47°W 60.0'
14" N. PINE S52°W 98.4'

C. EUGENE OSTLING, RLS
L265, P613
FD 1/2" BAR
G.D. HENNING WITNESSES
14" NORWAY PINE S52°W 98.4'
6" NORWAY PINE S48°E 113.6'
10" J. PINE N47°W 60.0'

GARY G. WILSON, LLS 1992
MON RAISED WITH 5/8" X 24"
RE-BAR & CAP 2.6' E OF C/L
N57°E 76.61' 5" B OAK
S33°E 67.05' 8" R MAPLE
S62°W 69.82' 8" R PINE
N52°W 83.27' 6" BLACK OAK
N47°E 41.77' PROJECT MARKER

1972 C. EUGENE OSTLING
LCRC L1, P53
SAME WITNESSES AS ABOVE

B. Description of corner evidence found and/or method applied in restoring or reestablishing corner:

FOUND 5/8" RE-ROD WITH 2" ALUMINUM CAP IN MONUMENT BOX
FOUND ALL WILSON 1992 WITNESSES
FOUND 10" J. PINE (NOW STUMP) N47°W

A PERPETUATION OF THE ORIGINAL GOVERNMENT CORNER.


C. Description of monument for corner and accessories established to perpetuate locating the position of the corner:

LEFT 5/8" RE-ROD WITH ALUMINUM CAP IN PLACE
WT: NAIL & TAG IN 10" J. PINE N47°W 60.0'
NAIL & TAG IN 8" RED MAPLE S33°E 67.05'
NAIL & TAG IN 8" RED PINE S62°W 69.82'
NAIL & TAG IN 6" BLACK OAK N52°W 83.27'
CARSONITE POST N56°E 33.15'

ROSCOMMON COUNTY
PEER GROUP APPROVAL

DATE Sept 10, 1999

Marvin E. Myers, P.S.
County Surveyor

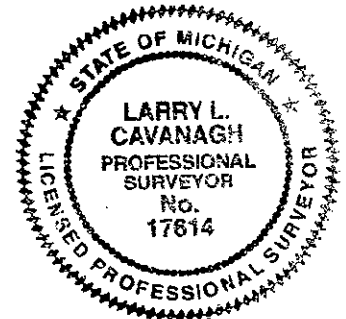

Signed by Larry L. Cavanagh
Surveyor's Michigan License NO. 17614

Date Sept. 14, 1999

FORM APPROVED BY MICHIGAN STATE BOARD OF LAND SURVEYORS, JAN 28, 1971
REVISED MAY 14, 1975
REVISED JAN., 1983

LIBER 3 PAGE 615
SECTION