

ROSCOMMON COUNTY  
PEER GROUP APPROVAL  
DATE 11-29-94

ROSCOMMON COUNTY REMONUMENTATION  
LAND CORNER RECORDATION CERTIFICATE  
Filing Requirement of Act 74, Mich. P.A. 1970

JAN 24 1996  
COMMISSION

For corners in  
ROSCOMMON  
(County)

Located In:

Corner Code #

TO BE FILED IN LIBER 3 OF LAND CORNER

STATE OF MICHIGAN  
ROSCOMMON COUNTY  
RECORDED

28 DEC 94 1:04 P.H.

ROBERT W. SMITH  
REGISTER OF DEEDS

Register of Deeds Stamp & File Number

- 1. Public Land Survey T 24N R 1W I-7  
T \_\_\_\_\_ R \_\_\_\_\_ SURVEY &  
T \_\_\_\_\_ R \_\_\_\_\_ REMONUMENTATION  
T \_\_\_\_\_ R \_\_\_\_\_
- 2. Property Controlling S \_\_\_\_\_ T \_\_\_\_\_ R \_\_\_\_\_  
in Section S \_\_\_\_\_ T \_\_\_\_\_ R \_\_\_\_\_ APR 05 1996
- 3. Miscellaneous S \_\_\_\_\_ T \_\_\_\_\_ R \_\_\_\_\_  
Property in Sec. S \_\_\_\_\_ T \_\_\_\_\_ R \_\_\_\_\_ COMMISSION
- 4. Lot No. \_\_\_\_\_, Recorded Plat \_\_\_\_\_
- 5. Private Claims \_\_\_\_\_

	A	B	C	D	E	F	G	H	I	J	K	L
2	6	5	4	3	2	1						
3												
4	7	8	9	10	11	12						
5												
6	18	17	16	15	14	13						
7												
8	19	20	21	22	23	24						
9												
10	30	29	28	27	26	25						
11												
12	31	32	33	34	35	36						
13												

Timothy L. Lapham, in a field survey on November, 1994, do hereby certify that under requirements of P.A. 74, Michigan P.A. of 1970, the corner points mentioned in lines 1 and 2 above were in conformance with regulations and rules therefore as required in the current manual of survey instructions of the United States Department of the Interior, Bureau of Land Management or by a decree of a Court of Law and/or that the corner points mentioned in lines 3, 4 and 5 above were in conformance with the rules of the Michigan Board of Land Surveyors or by a Decree of a Court of Law; established, re-established, monumented, re-monumented, recovered, found as expressed below:


NOTE: Not more than 4 corners, all in the same town and range, may be recorded on this certificate.

A. Description of original monument and accessories and/or subsequent restoration:  
I-7: 1852, Burt, 20" BEECH S44W 28 LINKS, 20" SUGAR N4E 65 LINKS  
DATE UNKNOWN, SURVEYOR UNKNOWN, OLD COR REC 2-446, 1"x16" BOLT, 3 WITNESSES; 10/04/47, HENNING, SURVEY, 1"x16" BOLT, 2 WITNESSES; 05/29/74, HENNING, SURVEY 290-141, SET 1/2" IRON BAR, NO WITNESSES; 07/23/75, CAVANAGH, SURVEY 306-220, FOUND BOAT SPIKE, 1 WITNESS; 08/08/75, CAVANAGH, SURVEY 306-679, FOUND BOAT SPIKE, 1 WITNESS; 09/01/75, CAVANAGH, SURVEY 309-524, 1" IRON, NO WITNESSES; 08/16/78, ARLETH, SURVEY 350-624, 1" BOLT, 2 WITNESSES; 07/29/80, WILCOX, LCRC 1-189, 1" BOLT, 4 WITNESSES; 02/23/81, WILCOX, LCRC

1-216, FOUND 1-1/4" HEX ROD, 4 WITNESSES; 02/05/91, ARLETH, SURVEY NOT RECORDED, 1" BOLT, 2 WITNESSES.

B. Description of corner evidence found and/or method applied in restoring or reestablishing corner:  
I-7: FOUND CORNER SET BY HENNING IN 1947. LIBER 2 COR REC PROBABLY MADE AS A RESULT OF THIS SURVEY. SUBSEQUENT SURVEYS ALL TIE TO THIS CORNER UNTIL 1980 WILCOX LCRC WHEN DIFFERENT CORNER FOUND 20" DEEP IN ROAD INTERSECTION. IN 1947 HENNING SET THE CORNER BASED ON PAROLE EVIDENCE OF THE CORNER POSITION. AFTER CONSIDERABLE DISCUSSION THE 1980 CORNER WAS REJECTED BY THE PEER COMMITTEE AND THE HENNING CORNER ACCEPTED AS THE BEST EVIDENCE OF THE CORRECT CORNER POSITION. SEE CORNER DOSSIER FOR ADDITIONAL INFORMATION. THIS CORNER ESTABLISHED IN ACCORDANCE WITH THE ROSCOMMON COUNTY REMONUMENTATION PROGRAM AND APPROVED AT A PEER REVIEW MEETING HELD ON NOVEMBER 29, 1994.

C. Description of monument for corner and accessories established to perpetuate locating the position of the corner:  
I-7: SET A 2-1/2" x 24" CAST IRON MONUMENT IN MONUMENT BOX WITH BRASS DISK MARKED "ROSCOMMON COUNTY 1994 27595"  
N78W 54.70' POWER POLE WITH NAIL AND TAG  
WEST 33.00' 1/2" BAR AND CAP  
WEST 1' WEST EDGE OF PAVEMENT  
S65W 22.62' 10" ELM WITH NAIL AND TAG  
N85E 42.12' POWER POLE WITH NAIL AND TAG  
S11E 26.70' 1/2" ROD IN MONUMENT BOX (PREVIOUSLY RECORDED CORNER POSITION BY WILCOX)

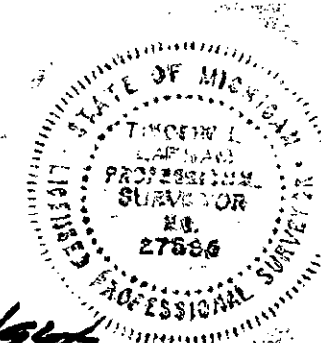

Signed by [Signature] Date 12/22/94  
Surveyor's Michigan License No. 27595

1. 2. 3. ID. - 912