


LAND CORNER RECORDATION CERTIFICATE
Filing Requirement of Act 74, Mich P.A. 1970

For corners in
 Roscommon County

Located in: _____ Corner Code # _____

1. Public Land Survey

T24N	R1W	J-1
T	R	_____
T	R	_____
T	R	_____

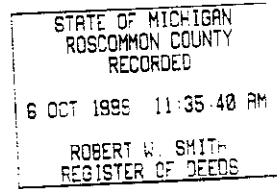

I, Larry L. Cavanagh, in a field survey May 1999, do hereby certify that under requirements of P.A. 74, Michigan P.A. of 1970, the corner points mentioned in line 1 above was in conformance with regulations and rules therefore as required in the current manual of survey instructions of the United States Department of the Interior, Bureau of Land Management or by a decree of a Court of Law; established, re-established, monumented, recovered, found as expressed below.

FILE IN LIBER 3 OF LAND CORNERS
 Register of Deeds Stamp & File Number

A. Description of original monument and accessories and/or subsequent restoration:

JOHN BRINK 1839
 SET POST
 PITCH PINE 9° N33 1/2°E 53 LKS
 PITCH PINE 9° N66°W 44 LKS

JAMES GRANGER, RLS 1972
 LCRC L1, P193
 FD MON WITH 1/2" ROD
 SAME WITNESSES AS ABOVE

T.N. CANADA 1937
 "FD NO EVIDENCE"
 SET CON MON 6" DIA X 24"
 BRASS CAP & STEM AT
 PROP DIST.
 (LOCAL BEARING TREES)
 B. OAK 14° N20 1/2°E 258 LKS
 J. PINE 12° N55 3/4°W 130 LKS
 (NEW BEARING TREES)
 B. OAK 8° N15 3/4°E 268 LKS
 J. PINE 7° N20°W 228 LKS

C. EUGENE OSTLING, RLS 1972
 L265, P613
 FD CONC MON
 G.D. HENNING WIT
 24" NORWAY PINE S9°W 72.6'
 5" NORWAY PINE S67°W 128.9'
 20" B. OAK N20°30'E 170.3'

LCRC 1970'S L2, P433
 CONC MON
 NORWAY PINE 24" S9°W 72.6'
 NORWAY PINE 5" S67°W 128.9'
 B. OAK 20° N20 1/2°E 170.3'

C. EUGENE OSTLING, RLS 1972
 LCRC L1, P53
 SAME WITNESSES AS ABOVE

G.D. HENNING, RLS 1978
 L357, P416
 NO MON MENTIONED
 24" R. PINE S9°W 72.6'
 5" R. PINE S67°W 128.9'
 20" B. OAK N30°30'E 170.3'
 12" B. OAK N16°E 176.9'

GARY G. WILSON, LLS 1992
 PLACED ORIGINAL BROKEN TOP ON
 GLO MON BASE & RAISED W/1/2"
 RE-ROD
 N18°E 111.92' SWLY COR HSE FOUNDATION
 S38°E 167.36' NW COR OF POOL HSE.
 S32°W 81.45' 8" RED PINE
 N68°W 146.08' 12" B. OAK

	A	B	C	D	E	F	G	H	I	J	K	L	M
2	6	5	4	3	2	1							
3													
4	7	8	9	10	11	12							
5													
6	18	17	16	15	14	13							
7													
8	19	20	21	22	23	24							
9													
10	30	29	28	27	26	25							
11													
12	31	32	33	34	35	36							
13													

JAMES GRANGER, RLS 1972
 RECORDED SURVEYS
 L123, P42; L123, P29; L123, P40
 L123, P41
 ALL LIST S 1/4 COR (NO MON)
 WIT: PROP. MARKER DUE SOUTH 32.9'
 30" PINE S5°W 72.20'
 COR FENCE POST S45°E 57.40'

B. Description of corner evidence found and/or method applied in restoring or reestablishing corner:

FOUND GLO MONUMENT 1.5' BELOW SURFACE
 FOUND 4' CONCRETE MONUMENT CALLED ECC POINT ON SURVEY IN SURVEY LIBER 383, PAGE 117 S10°E 2.2'
 FOUND ALL 1992 WITNESSES
 FOUND B OAK N15 3/4°E 176.9' (8' 37) (32' 99)
 FOUND B OAK N20 1/2°E 170.3 (14' 37) (34' 99)


A CAREFUL AND FAITHFUL ESTABLISHMENT OF THE POSITION OF THE CORNER.

C. Description of monument for corner and accessories established to perpetuate locating the position of the corner:

SET STANDARD CRAWFORD COUNTY MONUMENT (TOP 12" OVER US-GLO MONUMENT TO BRING TO SURFACE)
 WIT: NAIL & TAG IN SWLY COR HSE FOUNDATION N18°E 111.92'
 NAIL & TAG IN NW COR POOL HSE S38°E 167.36'
 NAIL & TAG IN 8" RED PINE S32°W 81.45'
 NAIL & TAG IN 12" BLACK OAK N68°W 146.08'
 FOREST SERVICE CARSONITE POST SOUTH 23.5'

ROSCOMMON COUNTY
PEER GROUP APPROVAL
 DATE Sept 10, 1999

Marvin E. Myers
 Marvin E. Myers, P.S.
 County Surveyor

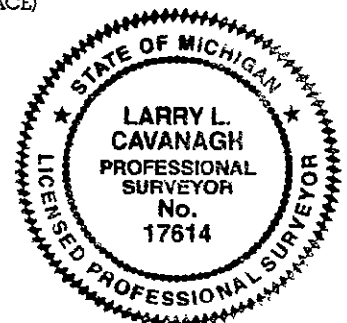

Signed by Larry L. Cavanagh
 Surveyor's Michigan License NO. 17614

Date Sept. 14, 1999

FORM APPROVED BY MICHIGAN STATE BOARD OF LAND SURVEYORS, JAN 28, 1971
 REVISED MAY 14, 1975
 REVISED JAN., 1983



RECEIVED
 2000
 SECTION