

SURVEY &
REMONUMENTATION

7873

LAND CORNER RECORDATION CERTIFICATE
Filing Requirement of Act 74, Mich. P.A. 1970

APR 07 1998

For corners in
Roscommon
(County)

Located In:

Corner Code #

SECTION

1. Public Land Survey	T 24N R 1W	J - 7
	T R	
	T R	
	T R	
2. Property Controlling in Section	S T R	
	S T R	
3. Miscellaneous Property in Section	S T R	
	S T R	

STATE OF MICHIGAN
ROSCOMMON COUNTY
RECORDED

30 OCT 97 12:30 P.M.

FILE IN LIBER ~~BOOK~~ ~~INDEX~~ CORNERS
REGISTER OF DEEDS
Register of Deeds Stamp & File Number

4. Lot No. _____, Recorded Plat _____
5. Private Claims _____

A	B	C	D	E	F	G	H	I	J	K	L
2	6	5	4	3	2	1					
3											
4	7	8	9	10	11	12					
5											
6	18	17	16	15	14	13					
7											
8	19	20	21	22	23	24					
9											
10	30	29	28	27	26	25					
11											
12	31	32	33	34	35	36					
13											

I, Marvin E. Myers, in a field survey on August, 19 97, do hereby certify that under requirements of P.A. 74, Michigan P.A. of 1970, the corner points mentioned in lines 1 and 2 above were in conformance with regulations and rules therefore as required in the current manual of survey instructions of the United States Department of the Interior, Bureau of Land Management or by a decree of a Court of Law and/or that the corner points mentioned in lines 3, 4 and 5 above were in conformance with the rules of the Michigan Board of Professional Surveyors or by a Decree of a Court of Law; established, re-established, monumented, re-monumented, recovered, found as expressed below:

NOTE: Not more than 4 corners, all in the same town and range, may be recorded on this certificate.

A. Description of original monument and accessories and/or subsequent restoration:

GLO - 1852 Wm. Burt, D.S. WIT: 12" Sugar S84°E 22 lks. 7" Sugar N55°W 18 lks.	LCRC L.1, pg. 186 J. Wilcox, P.S. #14102 Oct. 1980 Mon. - ½" reroed set midway and on line WIT: C _L road from West is 13' South Fence West 44' South Fence West 20' North Fence East 55' North Fence N & S 2' East	LCRC L.1, pg. 216 J. Wilcox, P.S. #14102 Feb. 1981 Mon. - Set ½" reroed with cap single on C of road West (note previously recorded at incorrect position) WIT: Fence West 30.5' South Fence West 33.5' North Fence East 68.5' North Fence N & S 1' West
---	--	--


B. Description of corner evidence found and/or method applied in restoring or reestablishing corner:

Found ½" bar N04°W 14.4 feet from midway and on line position. Set standard Roscommon County monument at the midway, on line, single proporate measure position. Accepted as a reestablishment of the position of the original government corner, by Roscommon County Peer Group.

**ROSCOMMON COUNTY
PEER GROUP APPROVAL
DATE Oct 2, 1997 MRW**

C. Description of monument for corner and accessories established to perpetuate locating the position of the corner:

Set standard Roscommon County monument
WIT: Nail & tag in fence post AZ 166° 6.71'
Nail & tag in fence post AZ 178° 18.75'
Nail & tag in fence post AZ 220° 29.38'
Nail & tag in fence post AZ 277° 20.10'
Carsonite post East 1'±
Fd. ½" bar N04°W 14.4'

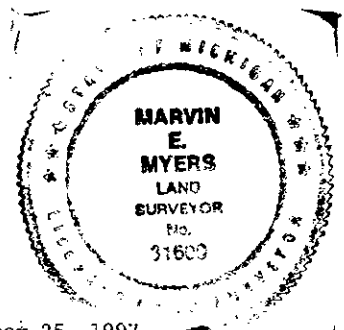

Signed by Marvin E. Myers
Surveyor's Michigan License No. 31600

Date October 25, 1997

1100 3 DATE 430