

**SURVEY &
REMONUMENTATION**

OCT 05 1998

2027

SECTION LAND CORNER RECORDATION CERTIFICATE
Filing Requirement of Act 74, Mich. P.A. 1970

STATE OF MICHIGAN
ROSCOMMON COUNTY
RECORDED

20 APR 98 2:19 P.M.

For corners in

<u>Roscommon</u> (County)	Located In:	Corner Code #
1. Public Land Survey	T <u>24N</u> R <u>1W</u>	<u>J-13</u>
	T <u>23N</u> R <u>1W</u>	<u>J-1</u>
	T _____ R _____	_____
	T _____ R _____	_____
2. Property Controlling in Section	S _____ T _____ R _____	_____
	S _____ T _____ R _____	_____
3. Miscellaneous Property in Sec.	S _____ T _____ R _____	_____
	S _____ T _____ R _____	_____

ROBERT W. SMITH
REGISTER OF DEEDS
To be filed in Liber 3 of Land
Corners

Register of Deeds Stamp & File Number

4. Lot No. _____, Recorded Plat _____
5. Private Claims _____

I, Marvin E. Myers, in a field survey on March 2, 1998 do hereby state that under requirements of P.A. 74, Michigan P.A. of 1970, the corner points mentioned in lines 1 and 2 above were in conformance with regulations and rules therefore as required in the current manual of survey instructions of the United States Department of the Interior, Bureau of Land Management or by a decree of a Court of Law and /or that the corner points mentioned in lines 3, 4 and 5 above were in conformance with the rules of the Michigan Board of Land Surveyors or by a Decree of a Court of Law; established, re-established, monumented, recovered, found as expressed below:

1	A	B	C	D	E	F	G	H	I	J	K	L	M
2	6			5			4		3		2		1
3													
4	7			8			9		10		11		12
5													
6	18			17			16		15		14		13
7													
8	19			20			21		22		23		24
9													
10	30			29			28		27		26		25
11													
12	31			32			33		34		35		36
13													

NOTE: Not more than 2 corners, all in the same town and range, may be recorded on this certificate.

A. Description of original monument and accessories and/or subsequent restoration:


J-13	G.L.O - 1838 Lewis Clason, DS Mon. - Post 7" Dead S. Pine N89°E 76 lks. 16" Y. Pine N85°W 437 lks.	1900's Marcus Schaaf Michigan Dept. of Conservation Mon: Found or established, and replaced
	L 1, Pg. 155 (Frank J. Arleth P.S. #21266 April 2, 1975) Mon. - Found 1 1/2" Pipe in Conc. Raised with 1/2" Bar 7" Dead S. Pine N89°E 76 lks. 6" J. Pine N45°E 58.8' 6" J. Pine S60°W 80.1'	L 2, Pg. 289 Mon. - 1 1/2" Pipe 6" J. Pine N45°E 58.8' 6" J. Pine S60°E 80.1'

ROSCOMMON COUNTY
PEER GROUP APPROVAL
DATE MARCH 27 1998
Marvin E. Myers
Marvin E. Myers, P.S.
County Surveyor

B. Description of corner evidence found and/or method applied in restoring or reestablishing corner:
Found 1/2" bar in 1 1/4" IP set in concrete (typical Schaaf monument) in flagged East - West line 160± South of the centerline of Marl Lake Road. Found post with Department of Conservation tag labeled N 1/4 cor. Sec. 2, T.23N. - R.1W.
Found 6" Jack Pine with spike in Northwest face N51°E 62.01'
Found blazed 8" Jack Pine with nail & tag in Southeast face N45°E 58.50'
Found blazed 10" Jack Pine with nail & tag in South face S60°E 80.10'
Found blazed 10" Jack Pine (dead) with spike in North face N85°W 68.49'
Accepted as a perpetuation of the Original Government Corner.
Replaced Schaaf monument with Standard Roscommon County Monument.

C. Description of monument for corner and accessories established to perpetuate locating the position of the corner:
Mon - Standard Roscommon County Monument.

Wit: 6" Jack Pine with spike in Northwest face N51°E 62.01'
8" Jack Pine with nail & tag in Southeast face N45°E 58.50'
10" Jack Pine with nail & tag in South face S60°E 80.10'
10" Jack Pine (dead) with spike in North face N85°W 68.49'
Set nail & tag in Southwest face 10" Jack Pine S42°E 90.99'
Set Carsonite post 1' South.

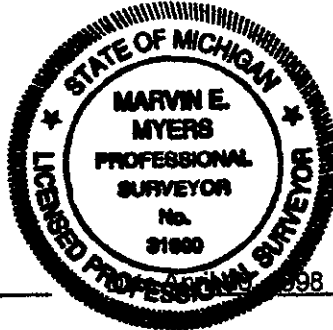

Signed by Marvin E. Myers
Surveyor's Michigan License No. 31660

LIBER 3 PAGE 500