

SURVEY &  
REMONUMENTATION

7874

APR 07 1998

LAND CORNER RECORDATION CERTIFICATE

Filing Requirement of Act 74, Mich. P.A. 1970

SECTION

STATE OF MICHIGAN  
ROSCOMMON COUNTY  
RECORDED

30 OCT 97 12:30 P.M.

ROBERT W. SMITH  
REGISTER OF DEEDS

FILE IN LIBER 3 OF LAND CORNERS

Register of Deeds Stamp & File Number

For corners in  
Roscommon  
(County)

Located In: \_\_\_\_\_ Corner Code # \_\_\_\_\_

1. Public Land Survey	T	<u>24N</u>	R	<u>1W</u>	<u>K - 7</u>
	T	_____	R	_____	_____
	T	_____	R	_____	_____
	T	_____	R	_____	_____
2. Property Controlling in Section	S	_____	T	_____	_____
	S	_____	T	_____	_____
3. Miscellaneous	S	_____	T	_____	_____
Property in Section	S	_____	T	_____	_____

4. Lot No. \_\_\_\_\_, Recorded Plat \_\_\_\_\_

5. Private Claims \_\_\_\_\_

A	B	C	D	E	F	G	H	I	J	K	L	M
2	6	5	4	3	2							
3												
4	7	8	9	10	11	12						
5												
6	18	17	16	15	14	13						
7												
8	19	20	21	22	23	24						
9												
10	30	29	28	27	26	25						
11												
12	31	32	33	34	35	36						
13												

I, Marvin E. Myers, in a field survey on July, 19 97, do hereby certify that under requirements of P.A. 74, Michigan P.A. of 1970, the corner points mentioned in lines 1 and 2 above were in conformance with regulations and rules therefore as required in the current manual of survey instructions of the United States Department of the Interior, Bureau of Land Management or by a decree of a Court of Law and/or that the corner points mentioned in lines 3, 4 and 5 above were in conformance with the rules of the Michigan Board of Professional Surveyors or by a Decree of a Court of Law; established, re-established, monumented, re-monumented, recovered, found as expressed below:

**NOTE: Not more than 4 corners, all in the same town and range, may be recorded on this certificate.**

A. Description of original monument and accessories and/or subsequent restoration:

GLO - June 1852 Wm. Burt, D.S.	LCRC Liber 1, pg.178 J. Wilcox, P.S. #14102 May 1980
Mon. - Post	Mon. - Fd. stake point badly decomposed 1.5' deep in muck & 2" square cedar stake remains on surface of grown over tree mounds at GLO
WIT: 8" Cedar N19°W 15 lks.	WIT: 16" Cedar S45°W 8.47'
8" Hemlock S51°E 5 lks.	5" Cedar S60°E 6.84'
Leaveswamp East 650 lks.	8" Cedar N50°W 5.21'
12 lks. wide stream (course NW) N88°W 360 lks.	5" Balsam N80°W 3.50'


B. Description of corner evidence found and/or method applied in restoring or reestablishing corner:

Found 1/2" iron & cap #14102  
Blaze & tag in 5" Balsam (dead & fallen over) N60°W 3.57'  
Blaze & tag in 8" Cedar (blown over) ±5'  
Blaze & tag in 5" Cedar (blown over) ±7'  
Blaze & tag in 16" Cedar S61°W 8.46'  
Accepted as a perpetuation of the original of government corner

ROSCOMMON COUNTY  
PEER GROUP APPROVAL  
DATE April 11, 1997 *MRM*

C. Description of monument for corner and accessories established to perpetuate locating the position of the corner:

Set standard Roscommon County monument  
WIT: Blaze & nail in 16" Cedar S61°W 8.46'  
Nail & tag in 10" Birch N40°W 7.50'  
Nail & tag in 8" Cedar N65°E 20.01'  
Nail & tag in 8" Tw.Cedar S23°E 12.60'

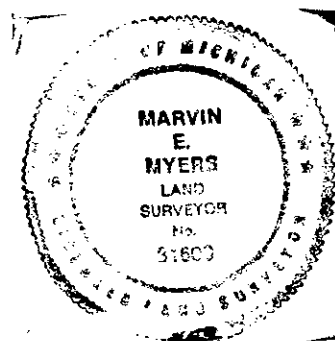

Signed by Marvin E. Myers

Date October 24, 1997

Surveyor's Michigan License No. 31600