

**SURVEY &
REMONUMENTATION**

7876

APR 07 1998

SECTION

LAND CORNER RECORDATION CERTIFICATE

Filing Requirement of Act 74, Mich. P.A. 1970

For corners in
Roscommon
(County)

Located In:

Corner Code #

- | | | | | | | |
|---|---|------------|---|-----------|--------------|-------|
| 1. Public Land Survey | T | <u>24N</u> | R | <u>1W</u> | <u>L - 7</u> | |
| | T | _____ | R | _____ | _____ | |
| | T | _____ | R | _____ | _____ | |
| | T | _____ | R | _____ | _____ | |
| 2. Property Controlling
in Section | S | _____ | T | _____ | R | _____ |
| | S | _____ | T | _____ | R | _____ |
| 3. Miscellaneous
Property in Section | S | _____ | T | _____ | R | _____ |
| | S | _____ | T | _____ | R | _____ |

STATE OF MICHIGAN
ROSCOMMON COUNTY
RECORDED

30 OCT 97 12:30 P.M.

ROBERT W. SMITH
REGISTER OF DEEDS

FILE IN LIBER 3 OF LAND CORNERS
Register of Deeds Stamp & File Number

4. Lot No. _____, Recorded Plat _____
5. Private Claims _____

A	B	C	D	E	F	G	H	I	J	K	L	N
2	6	5	4	3	2	1						
3												
4	7	8	9	10	11	12						
5												
6	18	17	16	15	14	13						
7												
8	19	20	21	22	23	24						
9												
10	30	29	28	27	26	25						
11												
12	31	32	33	34	35	36						
13												

I, Marvin E. Myers, in a field survey on July, 19 97, do hereby certify that under requirements of P.A. 74, Michigan P.A. of 1970, the corner points mentioned in lines 1 and 2 above were in conformance with regulations and rules therefore as required in the current manual of survey instructions of the United States Department of the Interior, Bureau of Land Management or by a decree of a Court of Law and/or that the corner points mentioned in lines 3, 4 and 5 above were in conformance with the rules of the Michigan Board of Professional Surveyors or by a Decree of a Court of Law; established, re-established, monumented, re-monumented, recovered, found as expressed below:

NOTE: Not more than 4 corners, all in the same town and range, may be recorded on this certificate.

A. Description of original monument and accessories and/or subsequent restoration:

GLO - June 21, 1852 Wm. Burt, D.S.	LCRC Liber 1, pg. 185 J. Wilcox, P.S. #14102
Mon. - Post	Sept. 1980
WIT: 12" Hemlock S70°E 5 lks.	Mon. - Set rerod & cap by single proportion
36" Elm N41½°W 28 lks.	WIT: 1" J.Pine S85°W 48.08'
	12" R.Pine N22°W 64.56'
	10" R.Pine N76°E 38.15'
	12" R.Pine S48°E 59.14'


B. Description of corner evidence found and/or method applied in restoring or reestablishing corner:

Found ½" bar & cap #14102, replaced with standard Roscommon County monument
4" J.Pine spike & blaze S85°W 48.16'
16" R.Pine blaze N76°E 38.12'
14" R.Pine spike & blaze N18°W 64.52'
14" R.Pine blaze S48°E 58.67'
Accepted as a careful and faithful establishment of the position of the corner

**ROSCOMMON COUNTY
PEER GROUP APPROVAL
DATE Aug 11, 1997 MEM**

C. Description of monument for corner and accessories established to perpetuate locating the position of the corner:

Mon.-Standard Roscommon County monument
WIT: Spike in 4" J.Pine S85°W 48.16'
Spike in 14" R.Pine N18°W 64.52'

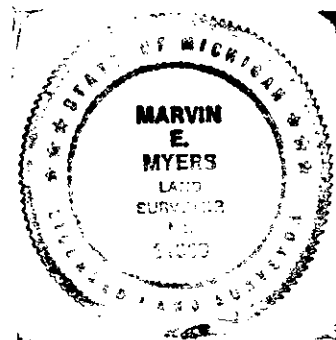

Signed by Marvin E. Myers

Date October 24, 1997

Surveyor's Michigan License No. 31600

FORM APPROVED BY MICHIGAN STATE BOARD OF PROFESSIONAL SURVEYORS, JAN. 28, 1971
REVISED MAY 14, 1975
REVISED JAN., 1983

LIBER 3 PAGE 433