

LAND CORNER RECORDATION CERTIFICATE
Filing Requirement of Act 74, Mich. P.A. 1970

For corners in

Common (County)	Located In:	Corner Code #/
1. Public Land Survey	T 24N R 2W	H-11
	T 24N R 2W	I-11
	T 24N R 2W	I-12
	T R	
2. Property Controlling in Section	S 34 T 24N R 2W	2
	S T R	
3. Miscellaneous Property in Sec.	S T R	
	S T R	

Register of Deeds Stamp & File Number

4. Lot No. _____, Recorded Plat _____
 5. Private Claims _____

I, **Carl R. Johnson**, in a field survey on Feb. 6, 19 86, do hereby certify that under requirements of P.A. 74, Michigan P.A. of 1970, the corner points mentioned in lines 1 and 2 above were in conformance with regulations and rules therefore as required in the current manual of survey instructions of the United States Department of the Interior, Bureau of Land Management or by a decree of a Court of Law and/or that the corner points mentioned in lines 3, 4 and 5 above were in conformance with the rules of the Michigan Board of Land Surveyors or by a Decree of a Court of Law; established, re-established, monumented, re-monumented, recovered, found as expressed below.

NOTE: Not more than 4 corners, all in the same town and range, may be recorded on this certificate.

A. Description of original monument and accessories and/or subsequent restoration:

	A	B	C	D	E	F	G	H	I	J	K	L	M
2	6	5	4	3	2	1							
3													
4	7	8	9	10	11	12							
5													
6	18	17	16	15	14	13							
7													
8	19	20	21	22	23	24							
9													
10	30	29	28	27	26	25							
11													
12	31	32	33	34	35	36							
13													

B. Description of corner evidence found and/or method applied in restoring or reestablishing corner:

H-11 - This corner was reestablished by G. D. Henning in a 1956 survey in Section 27.

2 - Corner set by standard survey procedure for subdivision of sections.

I-11 - Found 5" squared cedar post in place. Fits closely with G.D. Henning's measurements in 1956 survey of Section 27.

I-12 - Set corner midway and on line between section corners. No evidence of original or subsequent survey.


C. Description of monument for corner and accessories established to perpetuate locating the position of the corner:

H-11
 Found 1" iron shaft
 6" Jack Pine S26°W 5.7'
 9" Jack Pine N81°E 37.1'

I-11
 Set D.N.R. Mon. and Cedar Post
 4" Cedar N34°E 2.9'
 5" Cedar S54°E 3.5'
 4" Cedar S53°W 5.7'

2
 Set 5/8" bar w/cap and cedar post
 9" Cedar N 9°E 4.9'
 8" Cedar S35°E 8.6'

I-12
 Set D.N.R. Mon. and Cedar Post
 6" White Pine N31°E 12.
 6" Red Pine S33°E 25.9
 5" Jack Pine S26°W 13.2'

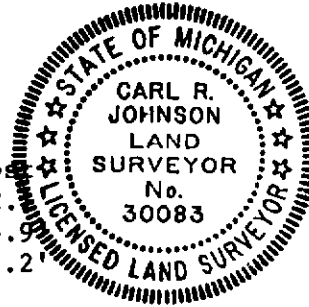

Signed by Carl R. Johnson Date 6/14/86
 Surveyor's Michigan License No. 30083