LAND CORNER RECORDATION CERTIFICATE Filing Requirement of Act 74, Mich. P.A. 1970

For corners in		
Roscommon	Located In:	Corner Code ##
1. Public Land Survey	T 24N R 2W	G-12 U
2. Property Controlling	T R T R S 34 T 24N R 2W	15 —
is Section	s 34 + 24N p 2W	4 <


Register of Deeds Stamp & File Number

...., Recorded Plat _____ Private Claims


Miscellaneous

Property in Sec.

, Carl R. Johnson in a field survey on Feb. 6 and 19, 19 86 do hereby certify that under requirements of P.A. 74, Michigan P.A. of 1970, the corner points mentioned in lines 1 and 2 above were in conformance with regulations and rules therefore as required in the current manual of survey instructions of the United States Department of the Interior, Bureau of Land Management or by a decree of a Court of Law and/or that the corner points mentioned in lines 3, 4 and 5 above were in conformance with the rules of the Michigan Board of Land Surveyors or by a Decree of a Court of Law, established, re-established, monumented, re-monumented, recovered, found as expressed below

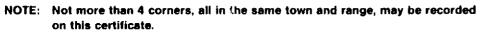

A. Description of original monument and accessories and/or subsequent restoration:

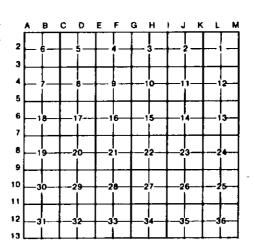

- B. Description of corner evidence found and/or method applied in restoring or reestablishing corner:
 - G-12 Set corner midway and on line between section corners. No evidence of original or subsequent survey.
 - 15 Set corner by standard survey procedure for subdivision of sections.
 - H-13 Found 14" pipe in concrete for corner presumed to have been set by Delamater in a survey of 1929. Also used by G. D. Henning in a previous survey.
 - 4 Set by standard survey procedure for subdivision of a section.
- C. Description of monument for corner and accessories established to perpetuate locating the position of the corner:

G-12 H-13Found 14" pipe in concrete set cedar post Set D.N.R. Mon. and cedar post N28 E 12" Red Oak S58^OW 12" Red Oak 40.21 N61°W 7" Maple N17°E 16" Red Oak 26.61 33.01 S43°W 13" Red Oak 17.1'

Set 5/8" bar w/cap and cedar post 7" Beech N15°E 18.6' Set 5/8" bar w/cap and cedar post 6" Maple S30°E 2.9' 7" Red Oak N77°W s85°W 29.11 5" Maple 19.6

_____ Date __ Signed by

Surveyor's Michigan License No. _____ 30083

FORM APPROVED BY MICHIGAN STATE BOARD O

LAND RVEYOR