LAND CORNER RECORDATION CERTIFICATE Filing Requirement of Act 74, Mich. P.A. 1970

For	corners	in


	Ros common (County)	Located In:	Corner Code ≟##
1.	Public Land Survey	T 24N, R 2W.	H-12
		T R	
2.	Property Controlling	S 34 T 24N R 2W S 34 T 24N R 2W	.5
3.	Miscellaneous Property in Sec.	S T R	


Register of Deeds Stamp & File Number

4.	Lot No.	, Recorded Pla	at	
5 .	Private Claims			

Feb. 19. I. Carl R. Johnson ..., in a field survey on .. do hereby certify that under requirements of P.A. 74, Michigan P.A. of 1970, the corner points mentioned in lines 1 and 2 above were in conformance with regulations and rules therefore as required in the current manual of survey instructions of the United States Department of the Interior, Bureau of Land Management or by a decree of a Court of Law and/or that the corner points mentioned in lines 3, 4 and 5 above were in conformance with the rules of the Michigan Board of Land Surveyors or by a Decree of a Court of Law, established, re-established, monumented, re-monumented, recovered, found as expressed below

NOTE: Not more than 4 corners, all in the same town and range, may be recorded on this certificate.

 

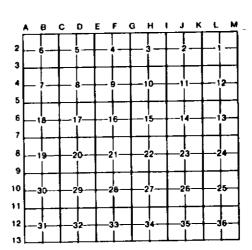

B. Description of corner evidence found and/or method applied in restoring or reestablishing corner:

5 - Set by standard survey procedure for subdivision of a section.

H-12 - Set at computed true intersection of 1/4 lines.

12 - Set by standard survey procedure for subdivision of a section.

C. Description of monument for corner and accessories established to perpetuate locating the position of the corner:

Set 5/8" bar w/cap and cedar post 6" Red Oak S47°E 4.5' Set 5/8" bar w/cap and cedar post 12" Maple S61°W 10" Red Pine S63°E 56.2 N 2°E 4" Red Oak 19.91 74.0

Set 5/8" bar w/cap and cedar post 10" Red Oak N66°W 15.7' 12" Red Oak N84°E 40.0'

Signed by Surveyor's Michigan License No.

30083

30083 SEO LAND S