LAND CORNER RECORDATION CERTIFICATE Filing Requirement of Act 74, Mich. P.A. 1970


For	r corners in		
	Roscommon	Located In:	Corner Code <i>≇‡</i>
1.	Public Land Survey	T 24N R 2W T 24N R 2W T 24N R 2W T R	G-11' G-13' F-13'
2.	Property Controlling in Section	S 34 T 24N R 2W S T R	1
3.	Miscellaneous Property in Sec.	S T R S T T R	


Register of Deeds Stamp & File Number

..., Recorded Plat 4. Lot No. **Private Claims**

Feb. 20, I, Carl R._Johnson _ , in a field survey on _ do hereby certify that under requirements of P.A. 74, Michigan P.A. of 1970, the corner points mentioned in lines 1 and 2 above were in conformance with regulations and rules therefore as required in the current manual of survey instructions of the United States Department of the Interior, Bureau of Land Management or by a decree of a Court of Law and/or that the corner points mentioned in lines 3, 4 and 5 above were in conformance with the rules of the Michigan Board of Land Surveyors or by a Decree of a Court of Law, established, re-established, monumented, re-monumented, recovered, found as expressed below:

NOTE: Not more than 4 corners, all in the same town and range, may be recorded on this certificate.

 

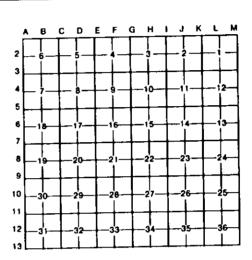

- B. Description of corner evidence found and/or method applied in restoring or reestablishing corner: 1 - Set by standard survey procedure for subdivision of a section.
 - G-11 Set by single proportionate measurement between found section corners north and south. No evidence of original corner.
 - G-13 Found 14" pipe in concrete in place. Assumed to have been established by Delamater in a survey of 1929.
 - F-13 Found 14" pipe in concrete in place. Assumed to have been set by Delamater in a survey of 1929.
- C. Description of monument for corner and accessories established to perpetuate locating the position of the corner:

1 🕊	G-13		
Set 5/8" bar w/cap & cedar post 5" Cedar S15°W 9.7' 5" Cedar N62°E 3.8' 4" Cedar N33°W 7.2'	Set D.N.R. Mon. and Cedar Post 10" White Oak N60°W 31.0' 5" Red Pine S39°E 65.3' 5" White Pine S27°W 30.7'		
G-11 Set D.N.R. Mon. and cedar post 4" Spruce N12 ^O W 24.7' 4" Spruce N48 ^O E 17.8'	F-13 Set D.N.R. Mon. and cedar post 14" Red Oak N55°E 28.9' 8" Red Oak N 9°W 8.3'		

Signed by

Surveyor's Michigan License No.

8" Spruce

30083

LAND LAND LAND

1