

# LAND CORNER RECORDATION CERTIFICATE

## FILING REQUIREMENT OF ACT 74, MICH. P.A.1970

FOR CORNERS OF--	LOCATED IN--	CORNER CODE NUMBER
1. PUBLIC LAND SURVEY.....	T. 24 N. R. 2 W.	E-12; D-12;
2. PROPERTY CONTROLLING IN SECTION 32	T. 24 N. R. 2 W.	9
3. MISCELLANEOUS PROPERTY IN SECTION.....	T. S. R. E. W.	
4. LOT NO. ...., RECORDED PLAT.....		
5. PRIVATE CLAIMS.....		

REGISTER OF DEEDS STAMP AND FILING NUMBER

I, KENNETH J. OSTLING, do hereby certify that under requirements of P.A. 74, Michigan P.A. of 1970, the corner points mentioned in lines 1 and 2 above were, in a field survey on DECEMBER 12, 1983, established, re-established, monumented, re-monumented, recovered or restored as expressed below and in conformance with regulations and rules therefore as required in the current manual of survey instructions of the United States Department of the Interior, Bureau of Land Management or by a decree of a court of law. Furthermore, that the corner points mentioned in lines 3, 4 and 5 above were, in a field survey on \_\_\_\_\_, 19\_\_\_\_, found, recovered, restored, established or re-established as expressed below and in conformance with the rules of the Michigan State Board of Registration for Land Surveyors or, by a Decree of a Court of law:

A. Description of original monument and accessories and/or subsequent restoration:

B. Description of corner evidence found and/or method applied in restoring or re-establishing corner:


- E-12 - FOUND 1/2" BAR AT CORNER AS ESTABLISHED BY G.F. DELAMATER IN 1929 SURVEY AND USED BY G.D. HENNING IN SUBSEQUENT SURVEY. U.S.B.T. STUMPS IN PLACE.
- D-12 - FOUND 1" PIPE AS ESTABLISHED BY G.F. DELAMATER IN 1929 SURVEY DURING A SECTION SUB-DIVISION.
- 9 - SET CORNER BY STANDARD SURVEY PROCEDURE FOR THE SUBDIVISION OF SECTIONS.

C. Description of monument for corner and accessories established to perpetuate locating the position of the corner:

<u>E-12</u>	<u>D-12</u>	<u>9</u>
LEFT 1/2" IRON BAR IN PLACE	LEFT 1" PIPE IN PLACE	SET 5/8" ROD W/RLS CAP
*10" J. PINE N72°E 81.2'	6" CEDAR S55°W 10.1'	5" CEDAR S55°W 7.0'
* 8" J. PINE N 3 1/2°W 47.5'	5" CEDAR S54°E 24.6'	6" CEDAR S13°E 16.9'
16" J. PINE N69°W 51.5'	SET 4" CEDAR POST W/LOC	SET 5" CEDAR POST W/LOC
* G.D. HENNING NBTS	TAG BY CORNER	TAG BY CORNER

SIGNED BY Kenneth J. Ostling  
 SURVEYOR'S MICHIGAN REGISTRATION NO. 10068

DATE 2/6/84

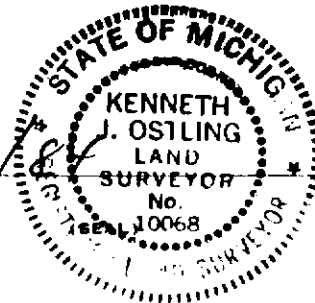

FOR STATE AND UNITED STATES AGENCIES:

SIGNED BY \_\_\_\_\_ DATE \_\_\_\_\_  
CHIEF OF SURVEY PARTY

APPROVED AND SIGNED BY \_\_\_\_\_ DATE \_\_\_\_\_  
MICHIGAN REGISTERED LAND SURVEYOR

(SEAL)

SURVEYOR'S MICHIGAN REGISTRATION NO. \_\_\_\_\_ ROSCOMMON COUNTY