LAND CORNER RECORDATION CERTIFICATE
Filing Requirement of Act 74, Mich. P.A. 1970

For corners in

Roscommon (County)

	Located In:	Corner Code #
1. Public Land Survey	T24N R 2W	F 6
	T____ R____	
	T____ R____	
2. Property Controlling	S 16 T24N R 2W	9
in Section	S____ T____ R____	
3. Miscellaneous	S____ T____ R____	
Property in Sec.	S____ T____ R____	

Register of Deeds Stamp & File Number

4. Lot No. _____ , Recorded Plat _____

5. Private Claims _____

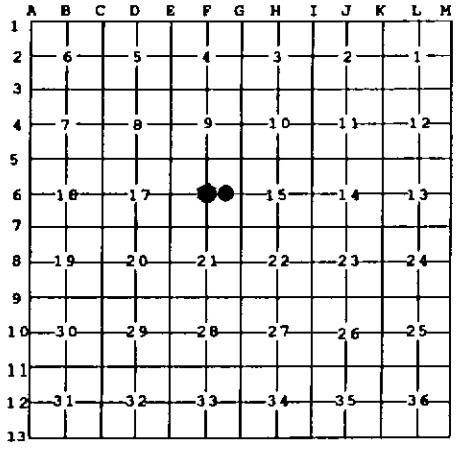

I, Craig W. McVean, in a field survey on July, 19 96 do hereby state that under requirements of P.A. 74, Michigan P.A. of 1970, the corner points mentioned in lines 1 and 2 above were in conformance with regulations and rules therefore as required in the current manual of survey instructions of the United States Department of the Interior, Bureau of Land Management or by a decree of a Court of Law and /or that the corner points mentioned in lines 3, 4 and 5 above were in conformance with the rules of the Michigan Board of Land Surveyors or by a Decree of a Court of Law; established, re-established, monumented, recovered, found as expressed below:

NOTE: Not more than 2 corners, all in the same town and range, may be recorded on this certificate.

A. Description of original monument and accessories and/or subsequent restoration:

F6 - None

9 - None

B. Description of corner evidence found and/or method applied in restoring or reestablishing corner:

F6 - C 1/4 Sec. 16
- Set 2" A.C. on 5/8" x 34"
Rebar per standard BLM Procedure

9 - CE 1/16 Cor. Sec. 16
- Set 2" A.C. on 5/8" x 34"
Rebar per standard BLM Procedure

C. Description of monument for corner and accessories established to perpetuate locating the position of the corner:

F6 - Mon per Part "B" w/carsonite guard post
S8°E 168.40' to N&T in W. Side 7" J. Pine
S30°E 186.98' to N&T in E Side 6" J. Pine
North 52.3' to S. Edge Bit Runway
North 126.5' to N. Edge Bit Runway
N74°W 46.78' 1/2" Rebar - SET
N62°E 71.18' Top CTR. Runway Light

9 - Mon per part "B" w/carsonite guard post
S2°E 160.97' N&T in E Side 4" J. Pine
S24°W 156.58' N&T in E Side 5" J. Pine
S38°W 202.12' N&T in SE Side 6" J. Pine
S45° 04' W 23.98' 3/4" Iron Pipe - FND.
N13° 44'E 45.95' 2 1/4" Iron Pipe - FND.

Signed by Craig W. McVean Date 1/22/1997

Surveyor's Michigan License No. 39088

FORM APPROVED BY MICHIGAN STATE BOARD OF PROFESSIONAL SURVEYORS, JAN. 28, 1971
REVISED MAY 14, 1975
REVISED JAN., 1983
REVISED OCT., 1995