

**LAND CORNER RECORDATION CERTIFICATE**  
**Filing Requirement of Act 74, Mich. P.A. 1970**

For corners in

<u>Roscommon</u> (County)	Located In:	Corner Code #
1. Public Land Survey	T _____ R _____	_____
	T _____ R _____	_____
	T _____ R _____	_____
2. Property Controlling In Section	S <u>16</u> T <u>24N</u> R <u>2W</u>	<u>11</u>
	S <u>16</u> T <u>24N</u> R <u>2W</u>	<u>12</u>
3. Miscellaneous Property in Sec.	S _____ T _____ R _____	_____
	S _____ T _____ R _____	_____

Register of Deeds Stamp & File Number

4. Lot No. \_\_\_\_\_, Recorded Plat \_\_\_\_\_  
 5. Private Claims \_\_\_\_\_


I, Craig W. McVean, in a field survey on July, 1996 do hereby state that under requirements of P.A. 74, Michigan P.A. of 1970, the corner points mentioned in lines 1 and 2 above were in conformance with regulations and rules therefore as required in the current manual of survey instructions of the United States Department of the Interior, Bureau of Land Management or by a decree of a Court of Law and /or that the corner points mentioned in lines 3, 4 and 5 above were in conformance with the rules of the Michigan Board of Land Surveyors or by a Decree of a Court of Law; established, re-established, monumented, recovered, found as expressed below:

A	B	C	D	E	F	G	H	I	J	K	L	M
1												
2	6	5	4	3	2	1						
3												
4	7	8	9	10	11	12						
5												
6	18	17	16	15	14	13						
7												
8	19	20	21	22	23	24						
9												
10	30	29	28	27	26	25						
11												
12	31	32	33	34	35	36						
13												

**NOTE:** Not more than 2 corners, all in the same town and range, may be recorded on this certificate.

**A. Description of original monument and accessories and/or subsequent restoration:**

- |  |   |
|--|---|
| <u>11</u> - Rec. Survey L. 263, P. 276 - 1/2" Iron Bar - G. Henning 1970<br>6" J. Pine S61°E 14.4'<br>5" J. Pine S53°W 46.8' | <u>12</u> - Rec. Survey L. 263 P. 276<br>1/2" Iron bar - G. Henning 1970<br>4" J. Pine S52°E 40.5'<br>7" J. Pine S65°W 46.4'<br>1/2" Iron Bar 33" West. |
|--|---|

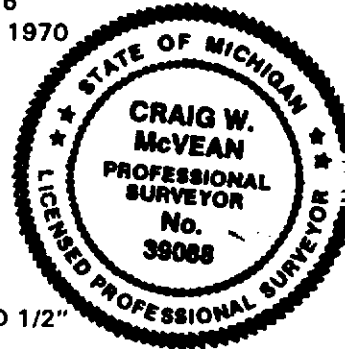

**B. Description of corner evidence found and/or method applied in restoring or reestablishing corner:**

- |   |  |
|---|--|
| <u>11</u> - SW 1/16 Cor. Sec. 16 - FND Capped 1/2" x 25" Rebar per rec. survey<br>0.32' N of True - Replaced 1/2" Rebar w/2" A.C. on 5/8" x 34" Rebar | <u>12</u> - CS 1/16 Cor. Sec. 16 - FND 1/2" Rebar per rec. survey<br>0.3'E. & 0.02'S of True. Place 1" x 1" Iron Pipe w/2" A.C. over Rebar - Down 0.5' |
|---|--|

**C. Description of monument for corner and accessories established to perpetuate locating the position of the corner:**

- |   |  |
|---|--|
| <u>11</u> - Mon per Part "B" w/Carsonite Guard Post<br>S61°E 14.7' to Blaze in 8" J. Pine (GH)<br>S53°W 47.1' to CL. Fallen 8" J. Pine (GH)<br>S20°W 18.20' to N&T in E. Side 7" J. Pine<br>N70°W 25.12' to N&T in NE Side 6" J. Pine | <u>12</u> - Mon. per Part 'B'<br>West 32.98' to Cap 1/2" Iron w/Carsonite Post (GH)<br>S65°W 46.3' to Blaze on 8" J. Pine (GH)<br>S52°E 40.7' to Blaze on 8" J. Pine (GH)<br>N20°E 59.09' to N&T in W. Side 8" J. Pine |
|---|--|

Signed by Craig W. McVean  
 Surveyor's Michigan License No. 39088

Date 1/22/1997