LAND CORNER RECORDATION CERTIFICATE
Filing Requirement of Act 74, Mich. P.A. 1970

Register of Deeds Stamp & File Number

For corners in

Roscommon (County)

	Located In:	Corner Code #
1. Public Land Survey	T ___ R ___	___
	T ___ R ___	___
	T ___ R ___	___
2. Property Controlling	S 16 T 24N R 2W	C-S-N 1/64
in Section	S 16 T 24N R 2W	C-S-NE 1/64
3. Miscellaneous	S ___ T ___ R ___	___
Property in Sec.	S ___ T ___ R ___	___

4. Lot No. _____ , Recorded Plat _____

5. Private Claims _____

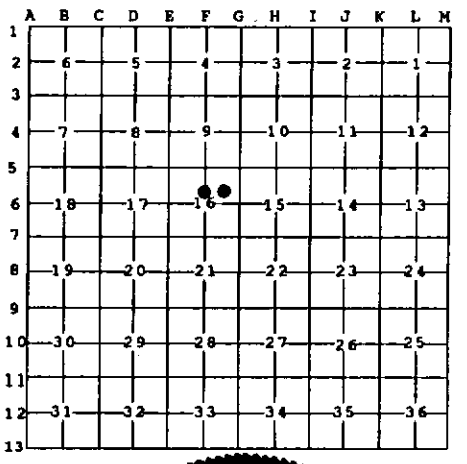

I, Craig W. McVean, in a field survey on July, 19 96 do hereby state that under requirements of P.A. 74, Michigan P.A. of 1970, the corner points mentioned in lines 1 and 2 above were in conformance with regulations and rules therefore as required in the current manual of survey instructions of the United States Department of the Interior, Bureau of Land Management or by a decree of a Court of Law and /or that the corner points mentioned in lines 3, 4 and 5 above were in conformance with the rules of the Michigan Board of Land Surveyors or by a Decree of a Court of Law; established, re-established, monumented, recovered, found as expressed below:

NOTE: Not more than 2 corners, all in the same town and range, may be recorded on this certificate.

A. Description of original monument and accessories and/or subsequent restoration:

CSN 1/64 - None

CSNE 1/64 - None

B. Description of corner evidence found and/or method applied in restoring or reestablishing corner:

CSN 1/64 - Set 2" A.C. on 5/8" x 34" Rebar per Standard BLM Procedure

CSNE 1/64 - Set 2" A. C. on 5/8" x 34" Rebar per Standard BLM Procedure

C. Description of monument for corner and accessories established to perpetuate locating the position of the corner:

CSN 1/64 - Mon per Part "B" w/casonite guard post
N44°W 15.21' to N&T in SW Side 4" J. Pine
N17°E 49.37' to N&T in E Side 3" J. Pine
N68°E 5.82' to N&T in S Side 12" J. Pine
S50° E 8.71' to N&T in S Side 5" J. Pine

CSNE 1/64 - Mon per Part "B"
N60°W 36.62' to N&T in SW Side 13" B. Oak
N 58°E 21.09' to N&T in NW Side 7" J. Pine
S21°E 11.64' to N&T in SW Side 8" J. Pine
E 1' Carsonite Post

Signed by Craig W. McVean Date 1/16/1997

Surveyor's Michigan License No. 39088

FORM APPROVED BY MICHIGAN STATE BOARD OF PROFESSIONAL SURVEYORS, JAN. 28, 1971
Revised May 14, 1975
Revised Jan. 1983
Revised Oct., 1995