

**SURVEY &  
REMONUMENTATION**

MAY 28 1997

COMMISSION

9586

**LAND CORNER RECORDATION CERTIFICATE  
Filing Requirement of Act 74, Mich. P.A. 1970**

STATE OF MICHIGAN  
ROSCOMMON COUNTY  
RECORDED

23 DEC 96 1:00 P.M.

ROBERT W. SMITH  
REGISTER OF DEEDS

For corners in

<u>Roscommon</u> <small>(County)</small>	Located In:	Corner Code #
1. Public Land Survey	T <u>24</u> R <u>2 W</u>	<u>A-3</u>
	T _____ R _____	_____
	T _____ R _____	_____
	T _____ R _____	_____
2. Property Controlling in Section	S _____ T _____ R _____	_____
	S _____ T _____ R _____	_____
3. Miscellaneous Property in Sec.	S _____ T _____ R _____	_____
	S _____ T _____ R _____	_____

Register of Deeds Stamp & File Number

4. Lot No. \_\_\_\_\_, Recorded Plat \_\_\_\_\_  
5. Private Claims \_\_\_\_\_

I, Frank J. Arleth, in a field survey on November, 19 96, do hereby certify that under requirements of P.A. 74, Michigan P.A. of 1970, the corner points mentioned in lines 1 and 2 above were in conformance with regulations and rules therefore as required in the current manual of survey instructions of the United States Department of the Interior, Bureau of Land Management or by a decree of a Court of Law and/or that the corner points mentioned in lines 3, 4 and 5 above were in conformance with the rules of the Michigan Board of Land Surveyors or by a Decree of a Court of Law; established, re-established, monumented, re-monumented, recovered, found as expressed below:

A	B	C	D	E	F	G	H	I	J	K	L	M
2	6	5	4	3	2	1						
3												
4	7	8	9	10	11	12						
5												
6	18	17	16	15	14	13						
7												
8	19	20	21	22	23	24						
9												
10	30	29	28	27	26	25						
11												
12	31	32	33	34	35	36						
13												

**NOTE: Not more than 4 corners, all in the same town and range, may be recorded on this certificate.**

A. Description of original monument and accessories and/or subsequent restoration:

John Brink 1836  
S. pine 8" N44°E 3.71  
S. pine 8" S75°E 1.60

Henning 1946  
used 5/8 iron bar  
B. T. 18" B. Oak N67°30'W 74.2  
B. T. 18" B. Oak N30°E 103.-  
B. T. 10" N. Pine S43°E 77.8  
Corner 54' North of Centerline  
of Hwy.

Henning & Ostling 1942  
restored by proportionate  
measurement on Town line  
5/8 iron bar in corner  
near fence corner.

Ostling 1956  
Plat of Brookside Acres  
Liber 4 of plats, page 3,  
section 7, T24N, R2W.

B. Description of corner evidence found and/or method applied in restoring or reestablishing corner:

Found 5/8 iron bar  
corner 54' North of Centerline of Hwy.  
Found Oak stump N30 E 103.0

**ROSCOMMON COUNTY  
PEER GROUP APPROVAL**


DATE 1 NOV 8 CH 1996

*Marvin E. Myers*  
Marvin E. Myers, P.S.  
County Surveyor

*MEP*

C. Description of monument for corner and accessories established to perpetuate locating the position of the corner:

Set Roscommon county Standar Mon. Stamped 21266 M-3  
N & T P. Pole S26°E 92.90  
N & T p. pole S23°W 94.35  
N & T W. pine 4" N57°E 50.13  
Face Gate post ( 2" pipe ) N50°W 57.90  
Carsonite post at corner

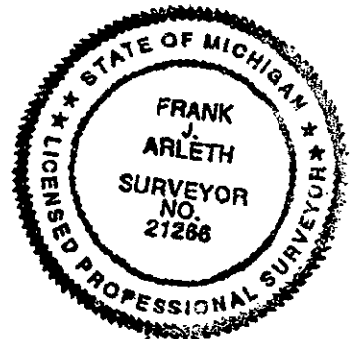

Signed by *Frank J. Arleth* Date 8 Nov 96

Surveyor's Michigan License No. 21266 P.S.

Date: 8 Nov 96

peer group approved.

LIBER 3 PAGE 371