

**SURVEY &  
REMONUMENTATION**

8370

APR 24 1995

ROSCOMMON COUNTY REMONUMENTATION

**LAND CORNER RECORDATION CERTIFICATE**  
Filing Requirement of Act 74, Mich. P.A. 1970

STATE OF MICHIGAN  
ROSCOMMON COUNTY  
RECORDED

For corners in  
Roscommon

**COMMISSION**

15 NOV 94 9:13 A.M.

ROBERT W. SMITH  
REGISTER OF DEEDS

Located In:	Corner Code #
1. Public Land Survey T <u>24</u> R <u>2</u> W	<u>B - 3</u>
T _____ R _____	_____
T _____ R _____	_____
T _____ R _____	_____
2. Property Controlling S _____ T _____ R _____	_____
in Section S _____ T _____ R _____	_____
3. Miscellaneous S _____ T _____ R _____	_____
Property in Sec. S _____ T _____ R _____	_____

TO BE FILED IN LIBER 3 OF LAND CORNERS

Register of Deeds Stamp & File Number

4. Lot No. \_\_\_\_\_, Recorded Plat \_\_\_\_\_  
5. Private Claims \_\_\_\_\_

	A	B	C	D	E	F	G	H	I	J	K	L	M
2	6	5	4	3	2	1							
3	7	8	9	10	11	12							
4													
5													
6	18	17	16	15	14	13							
7													
8	19	20	21	22	23	24							
9													
10	30	29	28	27	26	25							
11													
12	31	32	33	34	35	36							
13													

I, Frank J. Arleth, in a field survey on November, 19 94, do hereby certify that under requirements of P.A. 74, Michigan P.A. of 1970, the corner points mentioned in lines 1 and 2 above were in conformance with regulations and rules therefore as required in the current manual of survey instructions of the United States Department of the Interior, Bureau of Land Management or by a decree of a Court of Law and/or that the corner points mentioned in lines 3, 4 and 5 above were in conformance with the rules of the Michigan Board of Land Surveyors or by a Decree of a Court of Law, established, re-established, monumented, re-monumented, recovered, found as expressed below.

**NOTE: Not more than 4 corners, all in the same town and range, may be recorded on this certificate.**


**A. Description of original monument and accessories and/or subsequent restoration:**

Brink 1837 - Burt 1852 Set post  
No trees near

3/4" pipe set by Ostling survey 1952 in a section - Wit: 6" J. Pine S82°30'W 15.8  
subdivision 6" Aspen N35°30'E 15.1  
Surveys of record by Henning, Ostling, Cavanagh & Arleth  
for both Section 6 & 7.

**B. Description of corner evidence found and/or method applied in restoring or reestablishing corner:**

October 1994 Arleth found 3/4" pipe 32.8' N. of centerline county road #100. Above witness were destroyed by pipeline construction.  
Found Wit: Cavanagh  
Spike in N. side 6" Balsam N52°W 25.10  
Spike in P. pole S87°W 55.5  
Found M.S.H.D. Tag in T. pole S37°W 77.8'

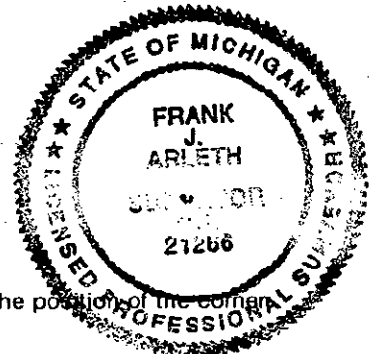

**C. Description of monument for corner and accessories established to perpetuate locating the position of the corner:**

Set Roscommon County standard monument B-3  
Found spike in N. side 6" Balsam N52°W 25.1  
N & T in 6" Tamarack N44°W 18.45  
N & T in 6" Balsam N26°W 34.70  
N & T in 4" sq. gasoline post S89°E 19.30  
Spike in P. pole S87°W 55.5  
MSHD tag in T. pole S37°W 77.80  
Carsonite survey post at corner.

Corner in Westerly cleared area for pipeline and 32.8' North of centerline of County Road #100.

Signed by Frank J. Arleth  
Surveyor's Michigan License No. 21266

Date 11/10/94

DATE 10/20/94

Peer Group Approved