SURVEY &
8368 REMONUMENTATION

ROSCOMMON COUNTY REMONUMENTATION

APR 2 4 1995

COMMISSION

LAND CORNER RECORDATION CERTIFICATE

Filing Requirement of Act 74, Mich. P.A. 1970

For corners in Roscommon (County) Located In: Corner Code ##

1. Public Land Survey	T 24	R 2 W	B-7	
	T	R		
	T	R		
	T	R		
2. Property Controlling	S T	R		
in Section	S T	R		
3. Miscellaneous	S T	R		
Property in Sec.	S T	R		

TO BE FILED IN LIBER 3 OF LAND CORNERS

Register of Deeds Stamp & File Number

4. Lot No. _____ , Recorded Plat _____
5. Private Claims _____

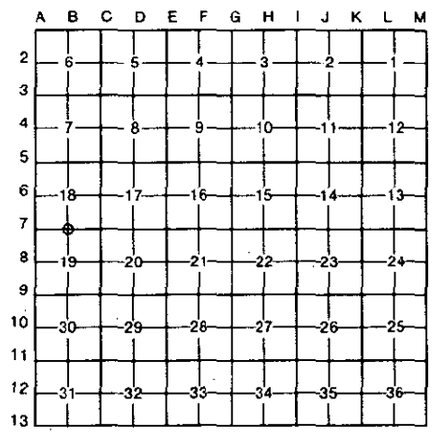

I, Frank J. Arleth, in a field survey on Novemenber, 19 94, do hereby certify that under requirements of P.A. 74, Michigan P.A. of 1970, the corner points mentioned in lines 1 and 2 above were in conformance with regulations and rules therefore as required in the current manual of survey instructions of the United States Department of the Interior, Bureau of Land Management or by a decree of a Court of Law and/or that the corner points mentioned in lines 3, 4 and 5 above were in conformance with the rules of the Michigan Board of Land Surveyors or by a Decree of a Court of Law; established, re-established, monumented, re-monumented, recovered, found as expressed below:

NOTE: Not more than 4 corners, all in the same town and range, may be recorded *on this certificate.*

A. Description of original monument and accessories and/or subsequent restoration:

Post Brink 1837 - Burt 1852
S. pine 8" N33°W 03 lks
S. pine 7" S73°E 31 lks
G.F. Delmater in 1929 set
½" x 30" bar
Henning Ostline set pipe over bar.
6" B. Oak S9°W 42.0
7" B. oak N32°E 31.1

Henning 1953 found pipe
B.T.7" B. oak S74°E 38.5
B.T.7" S36°30'W 34.2
B.T.18" oak S10°W 42.0
Corner used by Hughes #20706-1973

B. Description of corner evidence found and/or method applied in restoring or reestablishing corner:

Arleth October 1994 found pipe in corner 18.4 feedt south of centerline of Robinson lake road.
Henning witness : Found 10" B. oak S74°E 38.4
Destroyed 10" B. oak S36°30'W 34.1

STATE OF MICHIGAN
FRANK J. ARLETH
SURVEYOR NO. 21266
LICENSED PROFESSIONAL SURVEYOR

C. *Description of monument for corner and accessories established to perpetuate locating the position of the corner:*

Set Roscommon County standard monument B-7
N & T 14" B. Oak S69°30'E 38.75
N & T 24" B. Oak S10°W 42.18
N & T 18" B. Oak S59°30'W 72.45
N & T p. pole North 46.95
N & T p. pole S1°E 8.82
½" bar North 51.35'
Carsonite survey post 0.5' South

Corner is 18.4' South of centerline of Robinson Lake Road in ditch.

Signed by Frank J. Arleth Date 11/10/94

Surveyor's Michigan License No. 21266 P.S.

FORM APPROVED BY MICHIGAN STATE BOARD OF LAND SURVEYORS, JAN. 28, 1971
REVISED MAY 14, 1975
REVISED JAN., 1983

DATE 10/20/94 Peer Group Approved LIBER 3 PAGE 148