

8367

SURVEY & REMONUMENTATION

ROSCOMMON COUNTY REMONUMENTATION

APR 24 1994 LAND CORNER RECORDATION CERTIFICATE

Filing Requirement of Act 74, Mich. P.A. 1970

COMMISSION

For corners in

Roscommon

(County)

Located In:

Corner Code =#

- 1. Public Land Survey T 24 R 2 W C-2
- T _____ R _____
- T _____ R _____
- T _____ R _____
- 2. Property Controlling S _____ T _____ R _____
- in Section S _____ T _____ R _____
- 3. Miscellaneous S _____ T _____ R _____
- Property in Sec. S _____ T _____ R _____

- 4. Lot No. _____, Recorded Plat _____
- 5. Private Claims _____

TO BE FILED IN LIBER 3 OF LAND CORNERS

Register of Deeds Stamp & File Number

I, Frank J. Arleth, in a field survey on November, 19 94

do hereby certify that under requirements of P.A. 74, Michigan P.A. of 1970, the corner points mentioned in lines 1 and 2 above were in conformance with regulations and rules therefore as required in the current manual of survey instructions of the United States Department of the Interior, Bureau of Land Management or by a decree of a Court of Law and/or that the corner points mentioned in lines 3, 4 and 5 above were in conformance with the rules of the Michigan Board of Land Surveyors or by a Decree of a Court of Law; established, re-established, monumented, re-monumented, recovered, found as expressed below:

NOTE: Not more than 4 corners, all in the same town and range, may be recorded on this certificate.

A. Description of original monument and accessories and/or subsequent restoration:

William Burt Set Post 1852
W. Pine 18" N20°E, 29 Lks.
Y. Pine 8" S75°W, 95 Lks.

Ostling used Corner in 1959
Bearing Tree still living.


Henning and Ostling 1942
Found Iron Bar in Corner
Original USBT still living
36" Y. Pine S75 W, 62.70'
to old BT Mark in Base of Original Tree.

B. Description of corner evidence found and/or method applied in restoring or reestablishing corner:

November 1994 Arleth Found Original USBT still living
Found 1' X 1' Concrete Square with Spike on top of half-inch bar in concrete

C. Description of monument for corner and accessories established to perpetuate locating the position of the corner:

Used 1' x 1' Concrete Square with half-inch Bar
Found Original USBT 36" N. Pine, 62.70' (Y. Pine) -S75°W
Center of Nut on Top of Fire Hyd. S25°W, 87.20'
N&T Power Pole S21°E, 73.50'
N&T Elm N67°W, 23.32'
N&T Spruce N86°W, 26.85'
Concrete Retaining Wall 29' East To Bank Of The South Branch Of The AuSable River
Carsonite Survey Post 1.0 North of Corner.

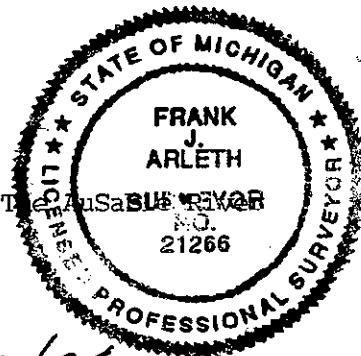

Signed by Frank J. Arleth

Date 11/10/94

Surveyor's Michigan License No. 21266

DATE: 10/20/94

Peer Group Approved

FORM APPROVED BY MICHIGAN STATE BOARD OF LAND SURVEYORS, JAN. 28, 1971
REVISED MAY 14, 1975
REVISED JAN., 1983

LIBER 3 PAGE 147