

8366 SURVEY & REMONUMENTATION

**ROSCOMMON COUNTY REMONUMENTATION
APR 24 1995 LAND CORNER RECORDATION CERTIFICATE
COMMISSION Filing Requirement of Act 74, Mich. P.A. 1970**

15 NOV 94 9:50 A.M.

For corners in

Roscommon (County) Located In: Corner Code #

1. Public Land Survey	T <u>24</u> R <u>2</u> W	C-3
	T _____ R _____	_____
	T _____ R _____	_____
	T _____ R _____	_____
2. Property Controlling in Section	S _____ T _____ R _____	_____
	S _____ T _____ R _____	_____
3. Miscellaneous Property in Sec.	S _____ T _____ R _____	_____
	S _____ T _____ R _____	_____

TO BE FILED IN LIBER 3 OF LAND CORNERS Register of Deeds Stamp & File Number

4. Lot No. _____, Recorded Plat _____
5. Private Claims _____

A	B	C	D	E	F	G	H	I	J	K	L	M
2	6	5	4	3	2	1						
3												
4	7	8	9	10	11	12						
5												
6	18	17	16	15	14	13						
7												
8	19	20	21	22	23	24						
9												
10	30	29	28	27	26	25						
11												
12	31	32	33	34	35	36						
13												

I, Frank J. Arleth, in a field survey on November, 1994


do hereby certify that under requirements of P.A. 74, Michigan P.A. of 1970, the corner points mentioned in lines 1 and 2 above were in conformance with regulations and rules therefore as required in the current manual of survey instructions of the United States Department of the Interior, Bureau of Land Management or by a decree of a Court of Law and/or that the corner points mentioned in lines 3, 4 and 5 above were in conformance with the rules of the Michigan Board of Land Surveyors or by a Decree of a Court of Law; established, re-established, monumented, re-monumented, recovered, found as expressed below:

NOTE: Not more than 4 corners, all in the same town and range, may be recorded on this certificate.

A. Description of original monument and accessories and/or subsequent restoration:
 Cedar Post Brink 1837 Burt 1852 Henning in 1946 recoved former from Delamater Wit:
 S. Pine 10" S62°30W 109 lks Henning Addition to Roscommon L. 3 P. 12, 10/18/46.
 S. pine 8" N 9°W 81 lks
 Concrete monument set for Village park subdivision, L. 5 P. 78, Ostline 10/10/67.
 Corner recovered & marked by G. F. Delamater in 1929, set 1/2" x 30? iron shaft
 8 " y. pine N43°E 82.4
 7" W. Pine N15°E 79.5

B. Description of corner evidence found and/or method applied in restoring or reestablishing corner:
 Arleth October 1994 found concrete plat monument.
 Found concrete monument 33.0 feet South.
 Above witness destroyed.

C. Description of monument for corner and accessories established to perpetuate locating the position of the corner:
 Concrete monument cap # 21266 C-3
 N & T in 10" B. oak N9°E 83.8
 N 7 T in N. Side of 8" pole set at walkway for bridge ove Robinson Creek S88°E 100.96'
 N & T in large aspen group on East side S10°E 97.48'
 Concrete monument 33.0 feet South
 Carsonite Survey marker North 10'.

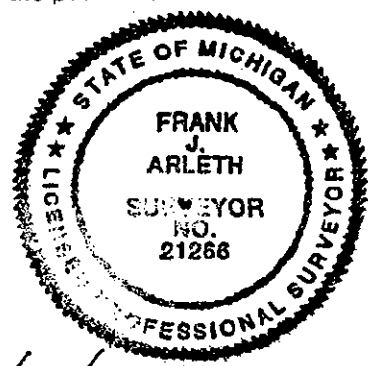

Signed by [Signature] Date 11/10/94
 Surveyor's Michigan License No. 21266 P.S.

FORM APPROVED BY MICHIGAN STATE BOARD OF LAND SURVEYORS, JAN. 28, 1971
 REVISED MAY 14, 1975
 REVISED JAN., 1983

Date 10/20/94 Peer Group Approved. [Signature] **LIBER 3 PAGE 146**