

**SURVEY &
REMONUMENTATION**

8365

APR 24 1995 ROSCOMMON COUNTY REMONUMENTATION

COMMISSION LAND CORNER RECORDATION CERTIFICATE
Filing Requirement of Act 74, Mich. P.A. 1970

STATE OF MICHIGAN
ROSCOMMON COUNTY
REGISTER

For corners in

ROSCOMMON
(County)

Located In: Corner Code #

15 NOV 94 9:07 A.M.

- | | | |
|------------------------------------|--------------------------|------------|
| 1. Public Land Survey | T <u>24</u> R <u>2 W</u> | <u>C-4</u> |
| | T _____ R _____ | _____ |
| | T _____ R _____ | _____ |
| | T _____ R _____ | _____ |
| 2. Property Controlling in Section | S _____ T _____ R _____ | _____ |
| | S _____ T _____ R _____ | _____ |
| 3. Miscellaneous Property in Sec. | S _____ T _____ R _____ | _____ |
| | S _____ T _____ R _____ | _____ |

STATE OF MICHIGAN
ROSCOMMON COUNTY
REGISTER

TO BE FILED IN LIBER 3 OF LAND CORNERS
Register of Deeds Stamp & File Number

4. Lot No. _____, Recorded Plat _____
5. Private Claims _____

	A	B	C	D	E	F	G	H	I	J	K	L	M
2	6	5	4	3	2	1							
3													
4	7	8	9	10	11	12							
5													
6	18	17	16	15	14	13							
7													
8	19	20	21	22	23	24							
9													
10	30	29	28	27	26	25							
11													
12	31	32	33	34	35	36							
13													

I, Frank J. Arleth, in a field survey on November, 19 94, do hereby certify that under requirements of P.A. 74, Michigan P.A. of 1970, the corner points mentioned in lines 1 and 2 above were in conformance with regulations and rules therefore as required in the current manual of survey instructions of the United States Department of the Interior, Bureau of Land Management or by a decree of a Court of Law and/or that the corner points mentioned in lines 3, 4 and 5 above were in conformance with the rules of the Michigan Board of Land Surveyors or by a Decree of a Court of Law; established, re-established, monumented, re-monumented, recovered, found as expressed below:

NOTE: Not more than 4 corners, all in the same town and range, may be recorded on this certificate.

A. Description of original monument and accessories and/or subsequent restoration:

BURT 1852 Set Cedar Post
Aspen 10" N49°W, 10 lks.
Aspen 10" S60°E, 9 lks.
1942 Section Subdivision by Henning and Ostling
Set 1" X 60" Pipe in Corner
Mkd. 4" Tamarack S48°W, 21.10'
Mkd. 6" Aspen N53°30'E, 26.10'
Mkd. 8" Balsam S74°E, 19.50'

Henning 1979 Found 1" Pipe
Mkd. 10" Spruce N36°30'E, 30.75'
Mkd. 6" Balsam N15°W, 56.55'
Mkd. 3" Balsam S10°W, 67.00'

CORNER IS ALSO THE SE. CORNER OF THE RECORDED PLAT OF THE KELSEY ADDITION TO ROSCOMMON, L, 2 OF PLATS, P, 75.
NOTE: HENNING AND OSTLING WITNESSES DESTROYED BY PIPE LINE.


B. Description of corner evidence found and/or method applied in restoring or reestablishing corner:

ARLETH 1994 Found 1" Pipe
Found 10" Spruce N36°30'E, 30.75'
Found 6" Balsam N15°W, 56.55' (Dead)

C. Description of monument for corner and accessories established to perpetuate locating the position of the corner:

SET ROSCOMMON STANDARD MONUMENT C-4
N&T in 4" Elm N82°E, 23.43'
N&T in 10" Spruce N36°30'E, 30.75'
N&T in 16" Balsam N85°E, 50.72'
N&T in 10" Balsam N15°W, 56.55' (Old and Dead)
N&T in 4" Aspen S30°E, 2.68'
SET CARSONITE SURVEY POST AT CORNER.

NOTE: CORNER SETS IN CLEAR AREA OF PIPE LINE.

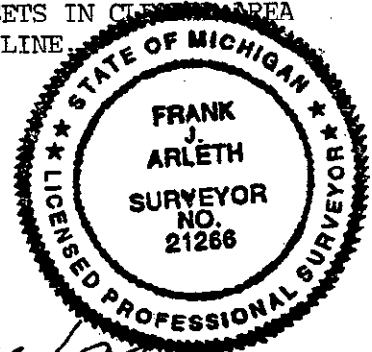

Signed by Frank J. Arleth Date 11/10/94
Surveyor's Michigan License No. 21266 P.S.

DATE: 10/20/94 Peer Group Approved

FORM APPROVED BY MICHIGAN STATE BOARD OF LAND SURVEYORS, JAN. 28, 1971
REVISED MAY 14, 1975
REVISED JAN., 1983

LIBER 3 PAGE 145