

8754

JAN 2 1996  
COMMISSION

LAND CORNER RECORDATION CERTIFICATE  
Filing Requirement of Act 74, Mich. P.A. 1970

For corners in

Roscommon  
(County)

Located In:

Corner Code #

- 1. Public Land Survey T 24 R 2 W E-3  
T \_\_\_\_\_ R \_\_\_\_\_  
T \_\_\_\_\_ R \_\_\_\_\_  
T \_\_\_\_\_ R \_\_\_\_\_
- 2. Property Controlling S \_\_\_\_\_ T \_\_\_\_\_ R \_\_\_\_\_  
in Section S \_\_\_\_\_ T \_\_\_\_\_ R \_\_\_\_\_
- 3. Miscellaneous S \_\_\_\_\_ T \_\_\_\_\_ R \_\_\_\_\_  
Property in Sec. S \_\_\_\_\_ T \_\_\_\_\_ R \_\_\_\_\_

~~SURVEY &~~  
~~REMONUMENTATION~~

APR 05 1996

STATE OF MICHIGAN  
ROSCOMMON COUNTY  
RECORDED

19 DEC 95 9:10 A.M.

ROBERT W. SMITH  
REGISTER OF DEEDS

Register of Deeds Stamp & File Number

- 4. Lot No. \_\_\_\_\_, Recorded Plat \_\_\_\_\_
- 5. Private Claims \_\_\_\_\_

COMMISSION

I, Frank J. Arleth, in a field survey on January, 19 95, do hereby certify that under requirements of P.A. 74, Michigan P.A. of 1970, the corner points mentioned in lines 1 and 2 above were in conformance with regulations and rules therefore as required in the current manual of survey instructions of the United States Department of the Interior, Bureau of Land Management or by a decree of a Court of Law and/or that the corner points mentioned in lines 3, 4 and 5 above were in conformance with the rules of the Michigan Board of Land Surveyors or by a Decree of a Court of Law; established, re-established, monumented, re-monumented, recovered, found as expressed below:

NOTE: Not more than 4 corners, all in the same town and range, may be recorded on this certificate.

- A. Description of original monument and accessories and/or subsequent restoration:  
 William Burt 1852 W. Pine 8" N85°W 34lks  
 W. Birch 8" N30°E 26 lks  
 10.68 chains South of River  
 G. F. DeLamater 1929 Set Cedar Post Fd. Stump of Orig. W. Pine  
 Mound of Earth N45°E 50.0'  
 Mound of Earth S45°W 50.0'  
 Henning 1961 Fd cedar post placed 1/2" bar in corner.  
 6" J. Pine S57°W 86.30'  
 14" J. Pine N17°W 70.80'  
 Arleth January 1977 Fd 1/2" bar  
 Sp. 8" Aspen N7°E 20.22'  
 Sp. 8" Aspen N46°E 7.48'  
 Sp. 6" Aspen S60°E 8.95'

Arleth 1980 Fd. 1/2" bar in corner. Wit. O K  
Arleth 1995 Fd. 1/2" bar  
Wit: Fd Sp 8" Aspen stump N7°E 20.22'  
Others Gone

- B. Description of corner evidence found and/or method applied in restoring or reestablishing corner:


Arleth January 1995  
Fd. 1/2" bar at corner  
Fd. spike 8" Aspen stump N7°E 20.22'  
Checked West to North 1/4 corner of Section 8, T24N, R2W. - S89°11'W  
2634.00' E.D.M. O.K. from previous survey of 1980.

ROSCOMMON COUNTY  
PEER GROUP APPROVAL  
DATE 12-8-1995

MEM

- C. Description of monument for corner and accessories established to perpetuate locating the position of the

Set Roscommon County Standard Monument Stamped E-3 (21266)-  
N & T 4" W. pine N81°E 68.41'  
N & T 12" B. Oak N4°W 53.48'  
N & T 6" J. Pine S49°W 23.40'  
N & T 14" B. Oak S36°E 41.00'  
N & T 8" B. Oak N67°30'W 70.22'  
Set carsonite post 1.0' North

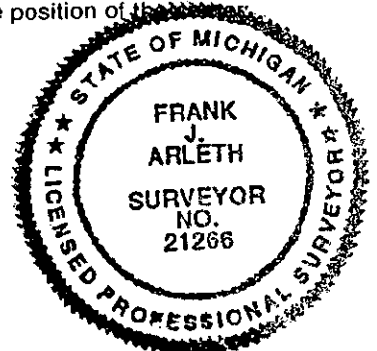

Signed by [Signature]  
Surveyor's Michigan License No. 21266

Date 12/8/95

Date 12/8/95 Peer Group Approval