

**SURVEY &
REMONUMENTATION**

9577

MAY 28 1997

LAND CORNER RECORDATION CERTIFICATE
Filing Requirement of Act 74, Michigan P.A. 1970

For corners in

<u>Roscommon</u> (County)	Located In:	Corner Code #
1. Public Land Survey	<u>T24N R 2W</u>	<u>F7</u>
	T ___ R ___	_____
	T ___ R ___	_____
	T ___ R ___	_____
2. Property Controlling in Section	S ___ T ___ R ___	_____
	S ___ T ___ R ___	_____
3. Miscellaneous Property in Sec.	S ___ T ___ R ___	_____
	S ___ T ___ R ___	_____

STATE OF MICHIGAN
ROSCOMMON COUNTY
RECORDED

23 DEC 96 10:46 A.M.

ROBERT W. SMITH
REGISTER OF DEEDS

Register of Deeds Stamp & File Number

4. Lot No. _____, Recorded Plat _____
5. Private Claims _____


I, Craig W. McVean, in a field survey on July, 1996 do hereby state that under requirements of P.A. 74, Michigan P.A. of 1970, the corner points mentioned in lines 1 and 2 above were in conformance with regulations and rules therefore as required in the current manual of survey instructions of the United States Department of the Interior, Bureau of Land Management or by a decree of a Court of Law and /or that the corner points mentioned in lines 3, 4 and 5 above were in conformance with the rules of the Michigan Board of Land Surveyors or by a Decree of a Court of Law; established, re-established, monumented, recovered, found as expressed below:

A	B	C	D	E	F	G	H	I	J	K	L	M
1												
2	6	5	4	3	2	1						
3												
4	7	8	9	10	11	12						
5												
6	18	17	16	15	14	13						
7												
8	19	20	21	22	23	24						
9												
10	30	29	28	27	26	25						
11												
12	31	32	33	34	35	36						
13												

NOTE: Not more than 2 corners, all in the same town and range, may be recorded on this certificate.

A. Description of original monument and accessories and/or subsequent restoration:

- F7 - Set 1/4 Sec. Post - Wm. Burt - 1852
 - S. Pine 8" N89 1/2°W 232 Lks.
 - Do. 6" N73°W 196 Lks.
- Placed Midway on Line - GF. DeLaMater - 1929
 - B. Oak 5" , S62.5°E 143.0'
 - S. Pine 10" N52°W 76.5'
- FND Pipe in road w/rec. Wits - G. Henning -1942
- Rec. survey L.263, P. 276 - Pipe in road - G. Henning - 1970
- G. Henning Wit. Sheet - Monument at corner w/2 GFD witnesses.

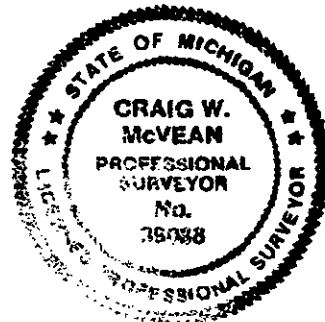

B. Description of corner evidence found and/or method applied in restoring or reestablishing corner:

- E7 - 1/4 Cor. Common to Sec. 16 & 21 - FND Broken Concrete Monument w/bent 1/2 Iron Rod in gravel road intersection with 1 GFI witness and GH Cap Iron to NW. Monument was set proportionally by G.F. DeLaMater and is accepted as a careful and faithful re-establishment of the position of the original corner.

C. Description of monument for corner and accessories established to perpetuate locating the position of the corner:

- E7 - Replace broken monument with 4" Alum. Cap on 1" x 36" Iron pipe w/ring of stone - Down O.7'
 - N52°W 76.7' to blaze scribed NBT on 16" J. Pine Stump (GFI)
 - N45°W 45.36' (46.5-R) to LS Cap 2240 (GH)
 - N42°E 49.74' to N&T in SE Side 6" B. Oak scribed' X BT'
 - S62°W 53.78' to N&T in S side 4" B. Oak scribed' X BT'
 - S10°E 103.31' to Nail in W side 6" J. Pine scribed' X BT'

ROSCOMMON COUNTY
PEER GROUP APPROVAL
DATE Aug 16, 1996

Marvin E. Myers
Marvin E. Myers, P.S.

County Surveyor
Date 11/26/1996

Signed by Craig W. McVean
Surveyor's Michigan License No. 39088