

SURVEY & LAND CORNER RECORDATION CERTIFICATE
REMONUMENTATION Filing Requirement of Act 74, Mich. P.A. 1970

STATE OF MICHIGAN
ROSCOMMON COUNTY
RECORDED

For corners in

Roscommon Located In: Corner Code #
(County) APR 24 1995

21 DEC 94 8:38 A.M.

ROBERT W. SMITH
REGISTER OF DEEDS

1. Public Land Survey	T 24N	R 2W	G - 2
	T	R	
	T	R	
	T	R	
2. Property Controlling in Section	S	T	R
	S	T	R
3. Miscellaneous Property in Sec.	S	T	R
	S	T	R

Register of Deeds Stamp & File Number

4. Lot No. _____, Recorded Plat _____
5. Private Claims _____

A	B	C	D	E	F	G	H	I	J	K	L	M
2	6	5	4	3	2	1						
3												
4	7	8	9	10	11	12						
5												
6	18	17	16	15	14	13						
7												
8	19	20	21	22	23	24						
9												
10	30	29	28	27	26	25						
11												
12	31	32	33	34	35	36						
13												

I, Marvin E. Myers, in a field survey on MAY 3, 19 94, do hereby certify that under requirements of P.A. 74, Michigan P.A. of 1970, the corner points mentioned in lines 1 and 2 above were in conformance with regulations and rules therefore as required in the current manual of survey instructions of the United States Department of the Interior, Bureau of Land Management or by a decree of a Court of Law and/or that the corner points mentioned in lines 3, 4 and 5 above were in conformance with the rules of the Michigan Board of Land Surveyors or by a Decree of a Court of Law; established, re-established, monumented, re-monumented, recovered, found as expressed below:

NOTE: Not more than 4 corners, all in the same town and range, may be recorded on this certificate.

A. Description of original monument and accessories and/or subsequent restoration:


GLO-June 1852 Burt Mon-Post WIT: 18" Y.Pine S19°W 180 lks. 12" Y.Pine S52°W 148 lks.	19 G.D. Henning Mon-3/4" Bar & Post WIT: 7" J.Pine S55°W 67.10' 7" J.Pine N39°W 81.60' 10" J.Pine S79°E 77.00'
L.2, pg.470 LCRC Mon-1/2" Bar WIT: 18" Norway S39°E 132.70' 12" J.Pine N51°E 147.60'	
L.2, pg.471 Same as Above	

B. Description of corner evidence found and/or method applied in restoring or reestablishing corner:

Found 3/4" Bar verified position by measurement to accessories of record.
Accepted as the best available evidence of the position of the original corner.

C. Description of monument for corner and accessories established to perpetuate locating the position of the corner:

Mon-Set Standard Roscommon County monument mark cap " 31600" over top of 3/4" bar.
Wit-Found nail & tag NE face 9" J. Pine S61°W 67.03
Found nail & tag SE face 8" J. Pine N31°W 81.65
Found nail & tag W. face 14" (dead) J. Pine S72°E 76.65
Set nail & tag NW side 6" J. Pine N50°E 61.03
Set nail & tag N. side Utility Pole S70°E 40.05
Centerline N-S road is East 19'±
Set carsonite post North 1.6'±

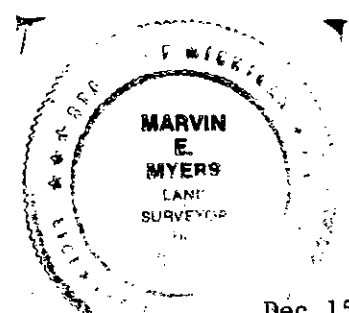

Signed by Marvin E. Myers

Date Dec 15, 1994

Surveyor's Michigan License No. 31600