

# SURVEY & REMONUMENTATION

MAY 28 1997

9573

## LAND CORNER RECORDATION CERTIFICATE Filing Requirement of Act 74, Michigan P.A. 1970

For corners in

Roscommon <small>(County)</small>	Located In:	Corner Code #
1. Public Land Survey	T <u>24N</u> R <u>2W</u>	<u>G7</u>
	T _____ R _____	_____
	T _____ R _____	_____
	T _____ R _____	_____
2. Property Controlling in Section	S _____ T _____ R _____	_____
	S _____ T _____ R _____	_____
3. Miscellaneous Property in Sec.	S _____ T _____ R _____	_____
	S _____ T _____ R _____	_____

STATE OF MICHIGAN  
ROSCOMMON COUNTY  
RECORDED


23 DEC 96 10:45 A.M.

ROBERT W. SMITH  
REGISTER OF DEEDS

Register of Deeds Stamp & File Number

4. Lot No. \_\_\_\_\_, Recorded Plat \_\_\_\_\_
5. Private Claims \_\_\_\_\_

I, Craig W. McVean, in a field survey on July, 19 96 do hereby state that under requirements of P.A. 74, Michigan P.A. of 1970, the corner points mentioned in lines 1 and 2 above were in conformance with regulations and rules therefore as required in the current manual of survey instructions of the United States Department of the Interior, Bureau of Land Management or by a decree of a Court of Law and /or that the corner points mentioned in lines 3, 4 and 5 above were in conformance with the rules of the Michigan Board of Land Surveyors or by a Decree of a Court of Law; established, re-established, monumented, recovered, found as expressed below:

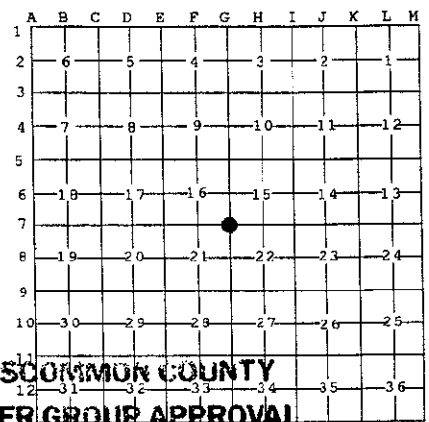

**ROSCOMMON COUNTY**  
**PEER GROUP APPROVAL**

**NOTE:** Not more than 2 corners, all in the same town and range, may be recorded on this certificate.

DATE Aug 16, 1996

*Marvin E. Myers*  
**Marvin E. Myers, P.S.**  
County Surveyor

**A. Description of original monument and accessories and/or subsequent restoration:**

- |   |   |
|---|---|
| <p><u>G7</u> - Set Post - Wm. Burt - 1852<br/>Y. Pine 18" N7°W 43 Lks.<br/>Do. 16" S26°E 47 Lks.</p> <p>- Found both Gov't BT's &amp; Post - G.F. DeLaMater - 1929<br/>Y. Pine - 20" S26°E 31.0' (GLO)<br/>Y. Pine 24" N45°E 36.6'<br/>Set 1/2" x 30" Bar</p> | <p>FND. 1/2" Bar - G. Henning - 1942 &amp; 1944<br/>BT Y. Pine Stp. N47 1/2°E 59.7'<br/>BT 4" B. Oak S17 1/2°E 44.2'<br/>BT 8" J. Pine S47°W 64.7'<br/>BT 7" B. Oak N56°W 50.2'</p> <p>- MDOT Wit. Sheet - 1948<br/>FND. 1/2" x 30" Iron Bar w/old cedar stake<br/>N45°W 9.73' 4" B.Oak<br/>S1°30'E 24.42' 6" B. Oak<br/>N49°E 36.6' 24" Pine Stump</p> |
|---|---|

**B. Description of corner evidence found and/or method applied in restoring or reestablishing corner:**

G7 - Sec. Corner Common to Sec. 15, 16, 21 & 22 - FND. 1/2" x 30" Iron Bar with 1-GFD, 2-MDOT & 1-GH Witnesses in agreement with Monument Position in Sand road. Monument accepted as a careful and faithful perpetuation of the position of the original corner.

**C. Description of monument for corner and accessories established to perpetuate locating the position of the corner:**

- G7 - Replace 1/2" x 30" Iron Bar w/ 4" Alum Cap on 1" x 36" Iron pipe - down 0.5  
N46°E 36.6' to Y. Pine Stump - (GFD)  
N56°W 50.50' to Set N&T in SW side 15" B. oak (GH)  
S6°E 23.78' to Set N&T in E side 15" B. Oak (MDOT)  
N45°W 9.52' to Set N&T in NE side 15" B. Oak (MDOT)  
N24°E 60.48' to N&T in SE side 10" Red Pine scribed' X BT'  
S54°E 38.19' to N&T in NE side 4" W. Pine scribed' X BT'  
North 15' to Carsonite Post



Signed by Craig W. McVean  
Surveyor's Michigan License No. 39088

Date 11/26/1996

LIBER 3 PAGE 364