

ROSCOMMON COUNTY  
PEER GROUP APPROVAL  
DATE Sept 15, 1994

**SURVEY &  
REMONUMENTATION AND CORNER RECORDATION CERTIFICATE**

Filing Requirement of Act 74, Mich. P.A. 1970

STATE OF MICHIGAN  
ROSCOMMON COUNTY  
RECORDED

For corners in

Roscommon  
(County)

APR 24 1995

Located In:

Corner Code #

COMMISSION

- 1. Public Land Survey T 24N R 2W H - 1
- T \_\_\_\_\_ R \_\_\_\_\_
- T \_\_\_\_\_ R \_\_\_\_\_
- T \_\_\_\_\_ R \_\_\_\_\_
- 2. Property Controlling S \_\_\_\_\_ T \_\_\_\_\_ R \_\_\_\_\_
- in Section S \_\_\_\_\_ T \_\_\_\_\_ R \_\_\_\_\_
- 3. Miscellaneous S \_\_\_\_\_ T \_\_\_\_\_ R \_\_\_\_\_
- Property in Sec. S \_\_\_\_\_ T \_\_\_\_\_ R \_\_\_\_\_

21 DEC 94 8:38 A.M.

ROBERT W. SMITH  
REGISTER OF DEEDS

Register of Deeds Stamp & File Number

- 4. Lot No. \_\_\_\_\_, Recorded Plat \_\_\_\_\_
- 5. Private Claims \_\_\_\_\_

A	B	C	D	E	F	G	H	I	J	K	L	M
2	6	5	4	3	2	1						
3												
4	7	8	9	10	11	12						
5												
6	18	17	16	15	14	13						
7												
8	19	20	21	22	23	24						
9												
10	30	29	28	27	26	25						
11												
12	31	32	33	34	35	36						
13												

I, Marvin E. Myers, in a field survey on May 3, 19 94, do hereby certify that under requirements of P.A. 74, Michigan P.A. of 1970, the corner points mentioned in lines 1 and 2 above were in conformance with regulations and rules therefore as required in the current manual of survey instructions of the United States Department of the Interior, Bureau of Land Management or by a decree of a Court of Law and/or that the corner points mentioned in lines 3, 4 and 5 above were in conformance with the rules of the Michigan Board of Land Surveyors or by a Decree of a Court of Law; established, re-established, monumented, re-monumented, recovered, found as expressed below:

**NOTE: Not more than 4 corners, all in the same town and range, may be recorded on this certificate.**

A. Description of original monument and accessories and/or subsequent restoration:


GLO-1838 J.Brinks	Sept. 1980 G.D. Henning
Mon-Post	Mon-Fd. RR Spike
WIT: 4" P.Pine N48°W 34 lks.	WIT: 8" J.Pine N40°W 53.20'
4" P.Pine N34°E 73 lks.	4" J.Pine N35°E 49.15'
	7" J.Pine S25°W 53.90'

B. Description of corner evidence found and/or method applied in restoring or reestablishing corner:

Found RR Spike verified position by measurement to accessories and corners of record.  
Accepted as the best available evidence of the position of the original corner.

C. Description of monument for corner and accessories established to perpetuate locating the position of the corner:

Mon- Set Standard Roscommon County monument mark cap " 31600".  
 Wit-Set nail & tag SW side 8" J. Pine N35°W 63.28  
 Set carsonite Post S05°W 39.63  
 Set nail & tag NW side 10" J. Pine S38°W 53.72  
 Set nail & tag NW side 4" J. Pine N39°E 40.20

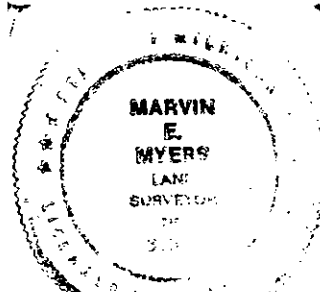

Signed by Marvin E. Myers

Date Dec 15, 1994

Surveyor's Michigan License No. 31600