

ROSCOMMON COUNTY
PEER GROUP APPROVAL

9267

DATE Sept 15, 1994

LAND CORNER RECORDATION CERTIFICATE
Filing Requirement of Act 74, Mich. P.A. 1970

STATE OF MICHIGAN
ROSCOMMON COUNTY
RECORDED

21 DEC 94 8:37 A.M.

ROBERT W. SMITH
REGISTER OF DEEDS

For corners in
Roscommon
REMONUMENTATION

Located In: _____ Corner Code # _____

1. Public Land Survey APR 24 1995 T 24N, R 2W _____ T-2 _____
 T _____ R _____
 T _____ R _____
 T _____ R _____
 T _____ R _____
2. Property Controlling S _____ T _____ R _____
 in Section S _____ T _____ R _____
 3. Miscellaneous S _____ T _____ R _____
 Property in Sec. S _____ T _____ R _____

Register of Deeds Stamp & File Number

4. Lot No. _____, Recorded Plat _____
 5. Private Claims _____

A	B	C	D	E	F	G	H	I	J	K	L	M
2	6	5	4	3	2	1						
3												
4	7	8	9	10	11	12						
5												
6	18	17	16	15	14	13						
7												
8	19	20	21	22	23	24						
9												
10	30	29	28	27	26	25						
11												
12	31	32	33	34	35	36						
13												

Marvin E. Myers in a field survey on May 3, 19 94
do hereby certify that under requirements of P.A. 74, Michigan P.A. of 1970, the corner points mentioned in lines 1 and 2 above were in conformance with regulations and rules therefore as required in the current manual of survey instructions of the United States Department of the Interior, Bureau of Land Management or by a decree of a Court of Law and/or that the corner points mentioned in lines 3, 4 and 5 above were in conformance with the rules of the Michigan Board of Land Surveyors or by a Decree of a Court of Law; established, re-established, monumented, re-monumented, recovered, found as expressed below:

NOTE: Not more than 4 corners, all in the same town and range, may be recorded on this certificate.


- A. Description of original monument and accessories and/or subsequent restoration:
 GLO-1852 Burt L.2, Pg. 470 same as L.2, P 469
 Mon-Post L. 270, P648 C.E. Ostling 12-1972
 Wit 8" S. Pine N32°E 79 lks. Mon- Fd 1/2" iron
 6" S. Pine S20°W 57 lks. Wit-10" B. Oak S44°15'W 49.30
 12" B. Oak N57°45'E 72.60
 L.2, Pg. 469 LCRC 12" B. Oak N41°15'W 32.10
 Mon-1/2" iron L.320, P426 F.J. Arleth 7-1976
 Wit- 10" B. Oak S44°W 49.30 Mon-Found 1 1/2" pipe
 12" B. Oak N57°3/4E 72.60 Wit- same as above
 12" B. Oak N41 1/2°W 32.10

- B. Description of corner evidence found and/or method applied in restoring or reestablishing corner:
 Found 3/4" pipe verified position by measurement to accessories of record.
 Accepted as the best available evidence of the position of the original corner.

- C. Description of monument for corner and accessories established to perpetuate locating the position of the corner:
 Mon-Set Standard Roscommon County monument mark cap " 31600".
 Wit-Set nail & tag SE side 8" J. Pine N56°E 59.63
 Set nail & tag SW side 8" J. Pine S57°E 19.65
 Set nail & tag SE side 13" B. Oak S47°W 49.81 found blaze on face and old tag on NE face.
 Set nail & tag SW side 8" J. Pine N32°W 20.08
 Found Blaze Se side 13" B. Oak N38°W 32.30
 Found Blaze SW side 13" B.Oak N64°E 72.70

Signed by Marvin E. Myers
 Surveyor's Michigan License No. 31600

Date Dec 15, 1994

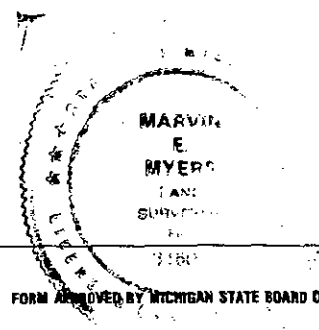

FORM APPROVED BY MICHIGAN STATE BOARD OF LAND SURVEYORS, JAN. 28, 1971
 REVISED MAY 14, 1975
 REVISED JAN., 1983

LIBER 3 PAGE 204