

LAND CORNER RECORDATION CERTIFICATE  
 Filing Requirement of Act 74, Mich. P.A. 1970

STATE OF MICHIGAN  
 ROSCOMMON COUNTY  
 RECORDED

For corners in SURVEY &

REMONUMENTATION

21 DEC 94 8:38 A.M.

ROBERT W. SMITH  
 REGISTER OF DEEDS

Roscommon (County) Located In: Corner Code #

1. Public Land Survey APR 24 1995 T 24N R 2W I - 3  
 COMMISSION T R  
 T R  
 T R

2. Property Controlling S T R  
 in Section S T R  
 3. Miscellaneous S T R  
 Property in Sec. S T R

Register of Deeds Stamp & File Number

4. Lot No. \_\_\_\_\_, Recorded Plat \_\_\_\_\_  
 5. Private Claims \_\_\_\_\_

	A	B	C	D	E	F	G	H	I	J	K	L	M
2	6	5	4	3	2								
3													
4	7	8	9	10	11	12							
5													
6	18	17	16	15	14	13							
7													
8	19	20	21	22	23	24							
9													
10	30	29	28	27	26	25							
11													
12	31	32	33	34	35	36							
13													

I, Marvin E. Myers, in a field survey on May 3, 19 94, do hereby certify that under requirements of P.A. 74, Michigan P.A. of 1970, the corner points mentioned in lines 1 and 2 above were in conformance with regulations and rules therefore as required in the current manual of survey instructions of the United States Department of the Interior, Bureau of Land Management or by a decree of a Court of Law and/or that the corner points mentioned in lines 3, 4 and 5 above were in conformance with the rules of the Michigan Board of Land Surveyors or by a Decree of a Court of Law; established, re-established, monumented, re-monumented, recovered, found as expressed below:

NOTE: Not more than 4 corners, all in the same town and range, may be recorded on this certificate.

A. Description of original monument and accessories and/or subsequent restoration:

GLO- June 1852 Burt  
 Mon-Post  
 WIT: 8" S.Pine N40°E 60 lks.  
 10" B.Oak S74°W 55 lks.

L.2, pg.476 LGRC (MSHD 1948)  
 Mon-½" Rod  
 WIT: 10" J.Pine S14°W 37.46'  
 10" J.Pine N79°W 26.95'  
 10" J.Pine N60°E 12.98'


B. Description of corner evidence found and/or method applied in restoring or reestablishing corner:

Found ½" bar verified by measurement to accessories of record.  
 Accepted as a perpetuation of the Original corner.

C. Description of monument for corner and accessories established to perpetuate locating the position of the corner:

Mon-Set Standard Roscommon County monument mark cap " 31600".  
 Wit-Found Blaze E. face 9" (dead) J. Pine West 15.4  
 Set nail & tag SE side 8" B. Oak S67°W 17.86  
 Set nail & tag NW side 11" B. Oak N46°E 20.45(found possible blaze on face)  
 Set nail & tag NE side 9" B. Oak S35°E 36.38  
 Set nail & tag SW side 9" B. Oak N43°W 46.46

Signed by Marvin E. Myers Date \_\_\_\_\_  
 Surveyor's Michigan License No. 31600

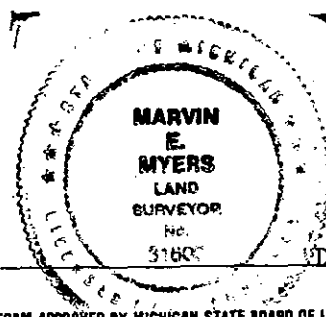

Dec 15, 1994